



ADDRESS: 1135 ADELAIDE STREET N MAIN FLOOR PLAN	SCALE 1/8" = 1'-0"		
	<small>This Product is Prepared by Home Max Tour Inc. Using Laser Technology (04.2013) T: 647-960-4688 contact@homemaxtour.ca Area computed in accordance with BCMA (1996) Standards</small>		

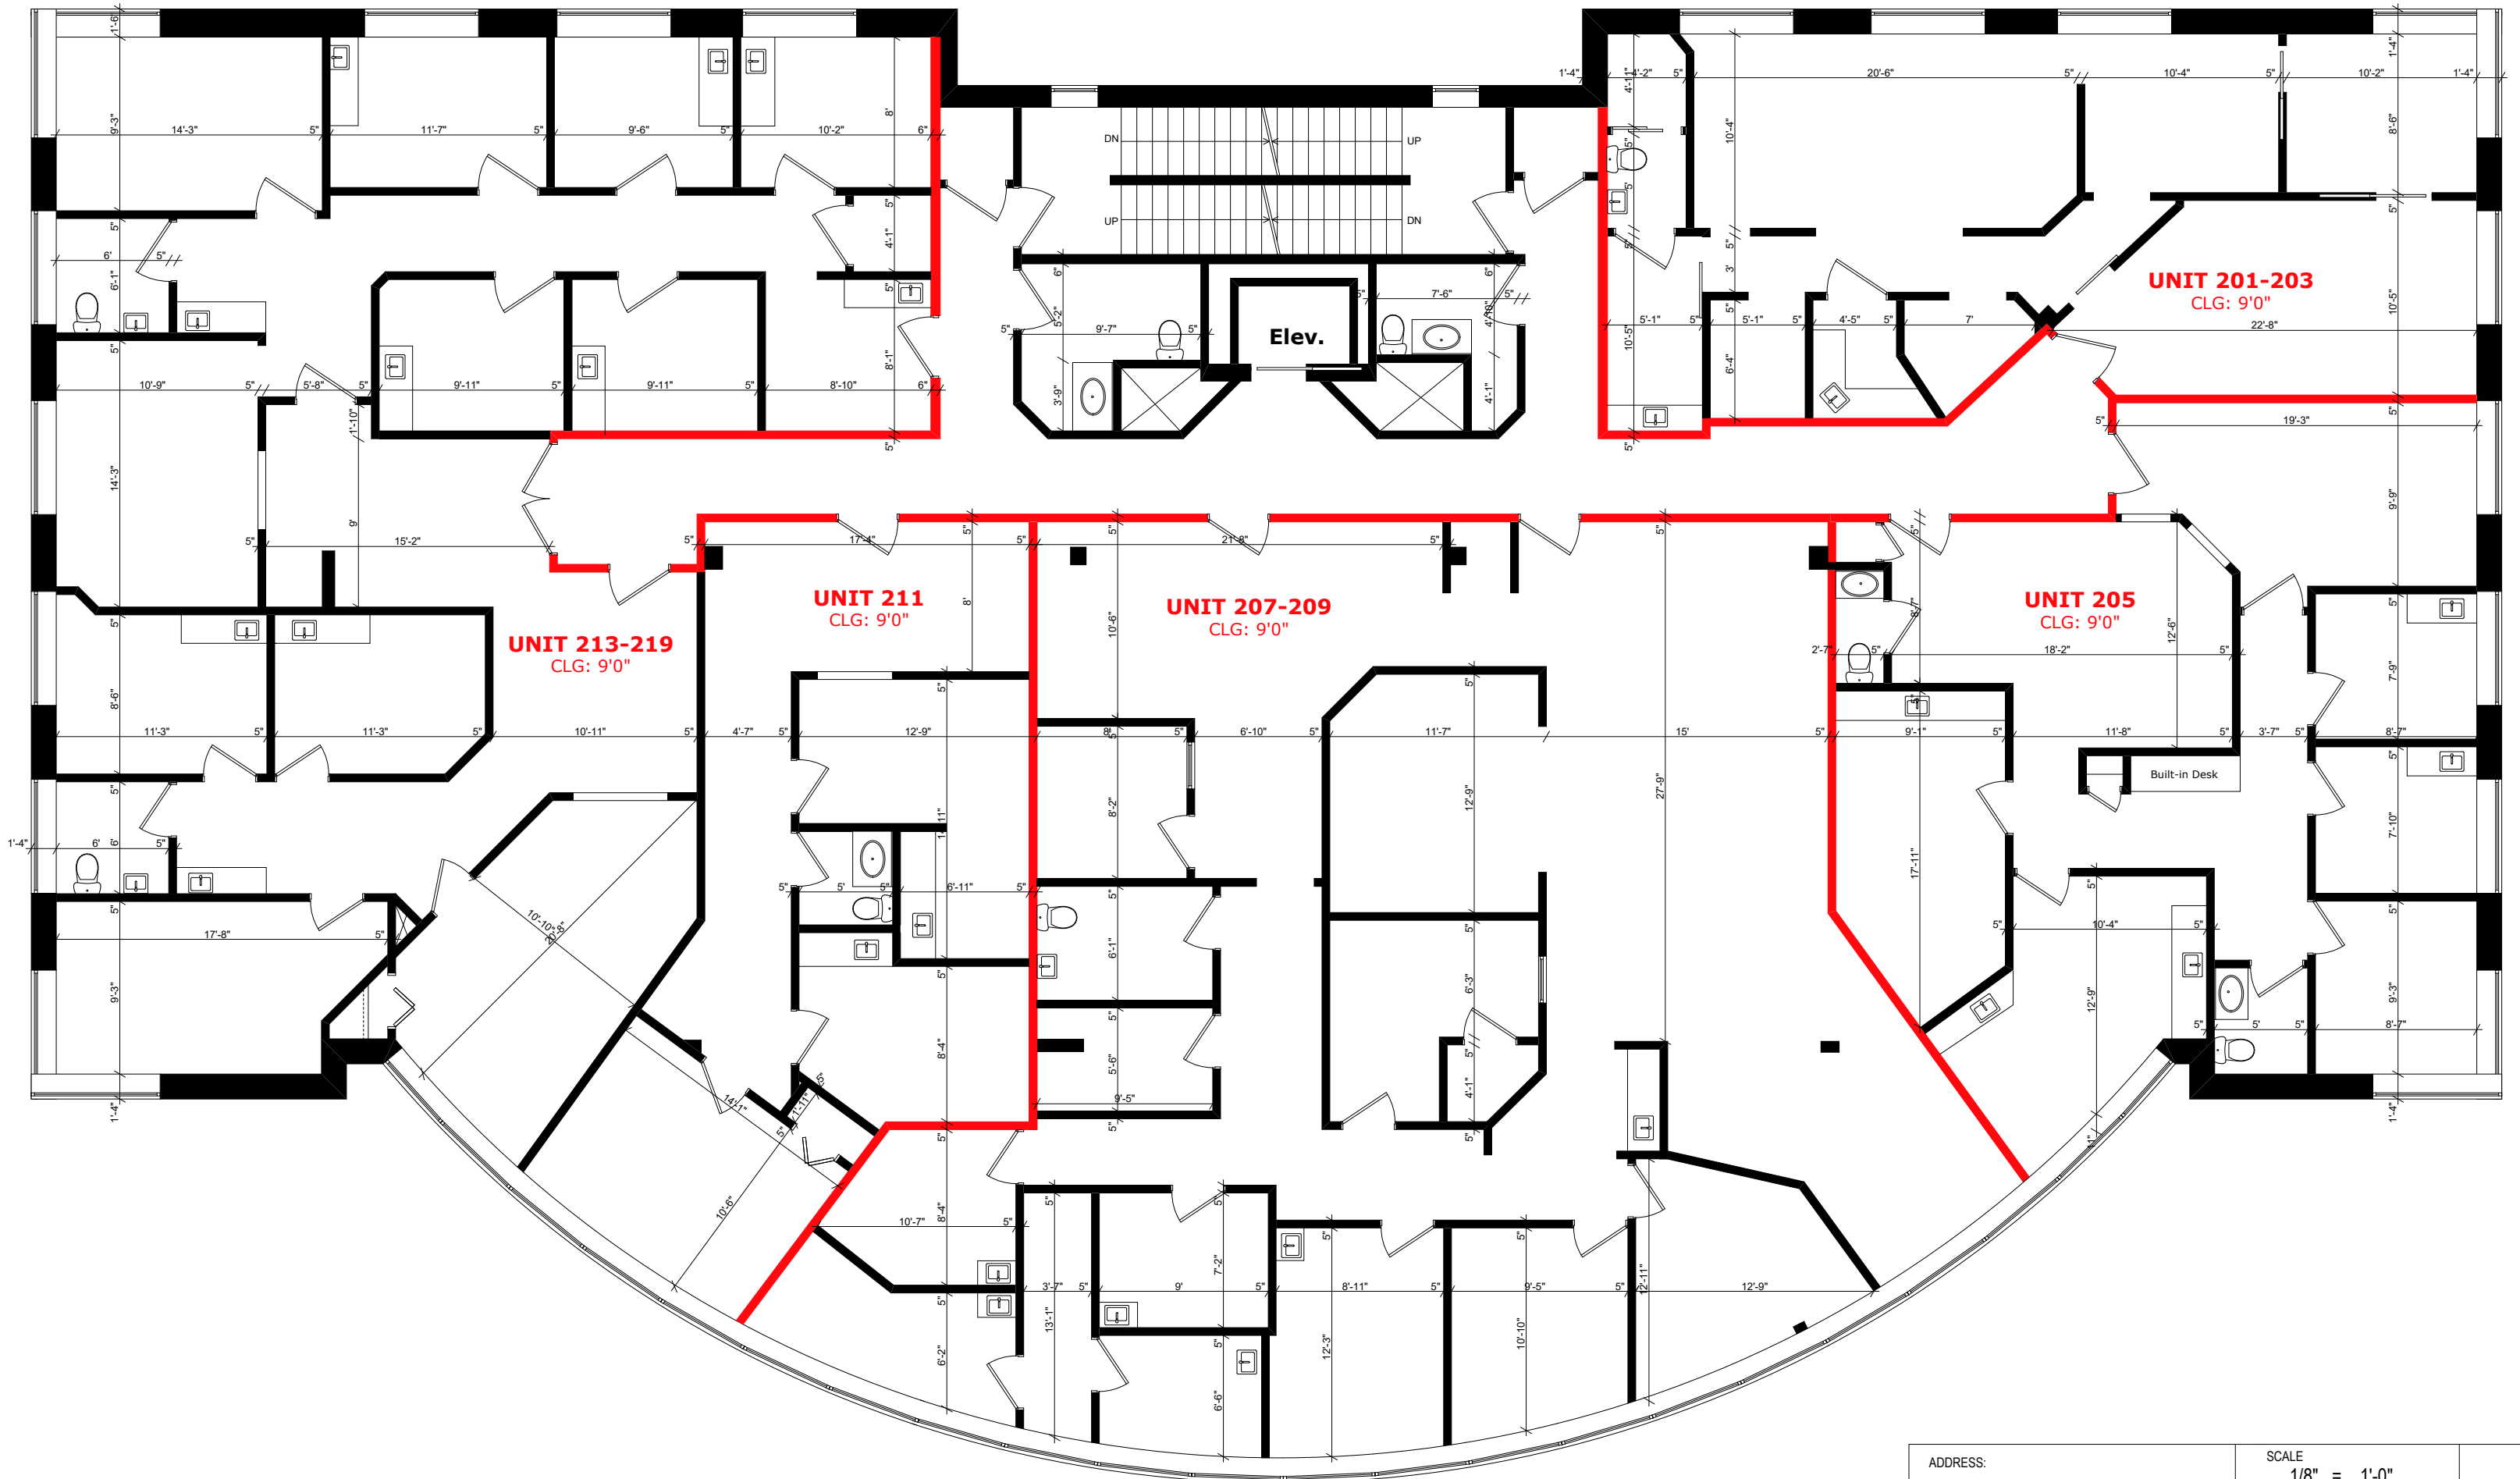

<p>ADDRESS: 1135 ADELAIDE STREET N SECOND FLOOR PLAN</p>	<p>SCALE 1/8" = 1'-0"</p> <p><small>This Product is Prepared by Home Max Tour Inc. Using Laser Technology (04.2013) T: 647-960-4688 contact@homemaxtour.ca Area computed in accordance with BCMA (1996) Standards</small></p>	
--	---	--

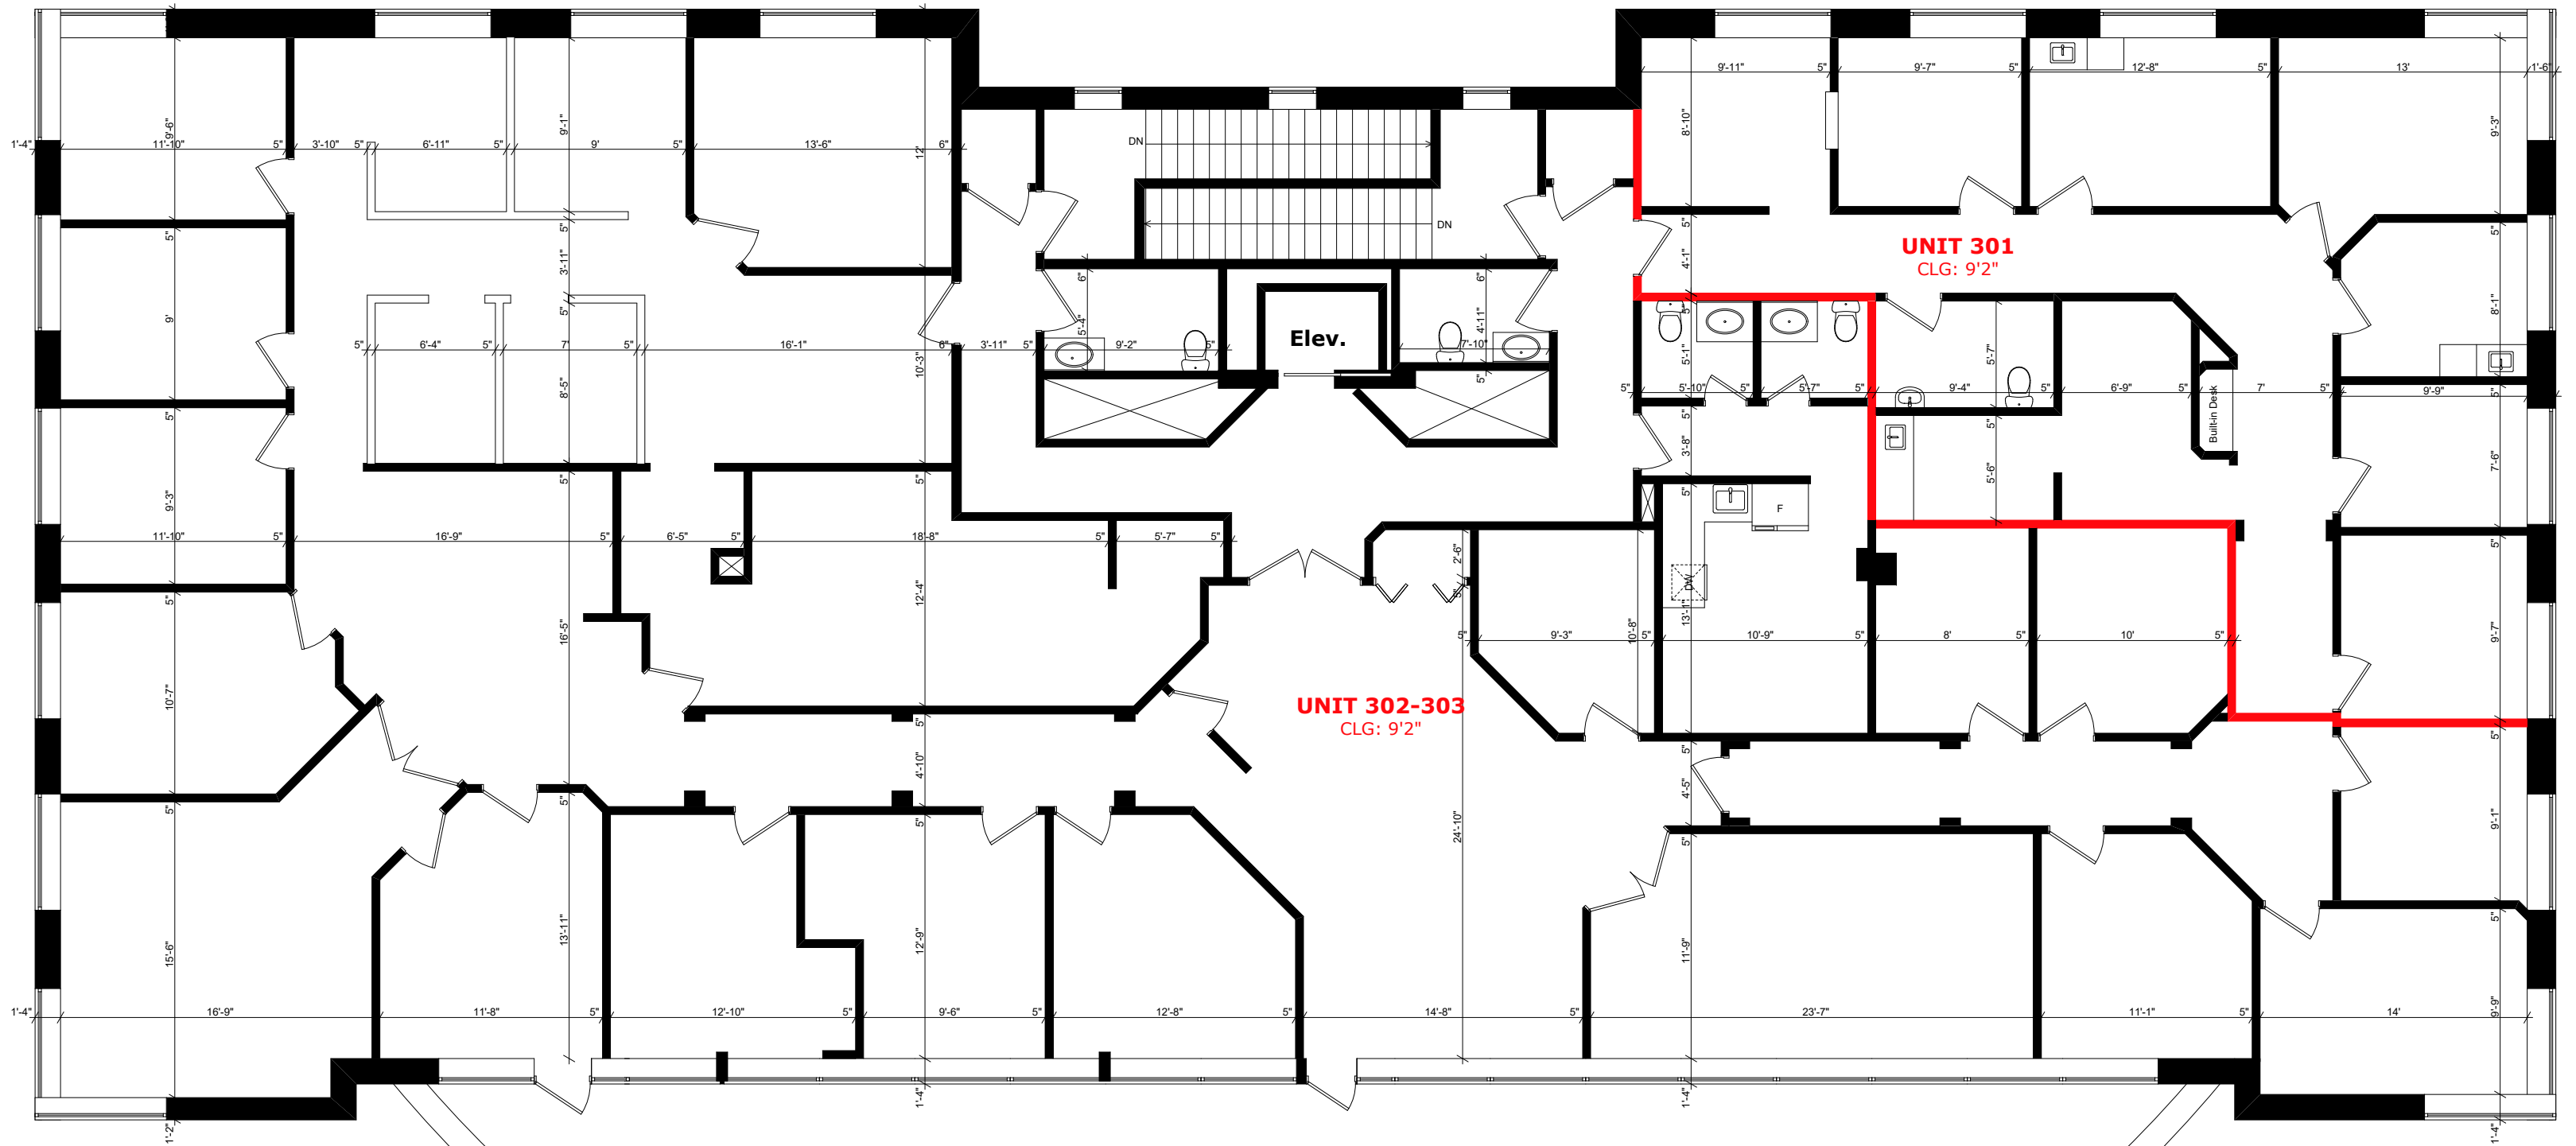

UNIT 301
CLG: 9'2"

UNIT 302-303
CLG: 9'2"

Elev.

Roof Patio

ADDRESS: 1135 ADELAIDE STREET N THIRD FLOOR PLAN	SCALE 1/8" = 1'-0"		
	<small>This Product is Prepared by Home Max Tour Inc. Using Laser Technology (04.2013) T: 647-960-4688 contact@homemaxtour.ca Area computed in accordance with BCMA (1996) Standards</small>		