





- BASIC LEASABLE AREA
- GROSS LEASABLE AREA
- BUILDING COMMON AREA

ADDRESS: 1790 DUNDAS STREET GROSS LEASABLE AREA	SCALE 3/32" = 1'-0"	
This Product is Prepared by Houssmax.ca Using Laser Technology @2013 T: 647-309-6288 info@houssmax.ca Area computed in accordance with BOMA Standards		

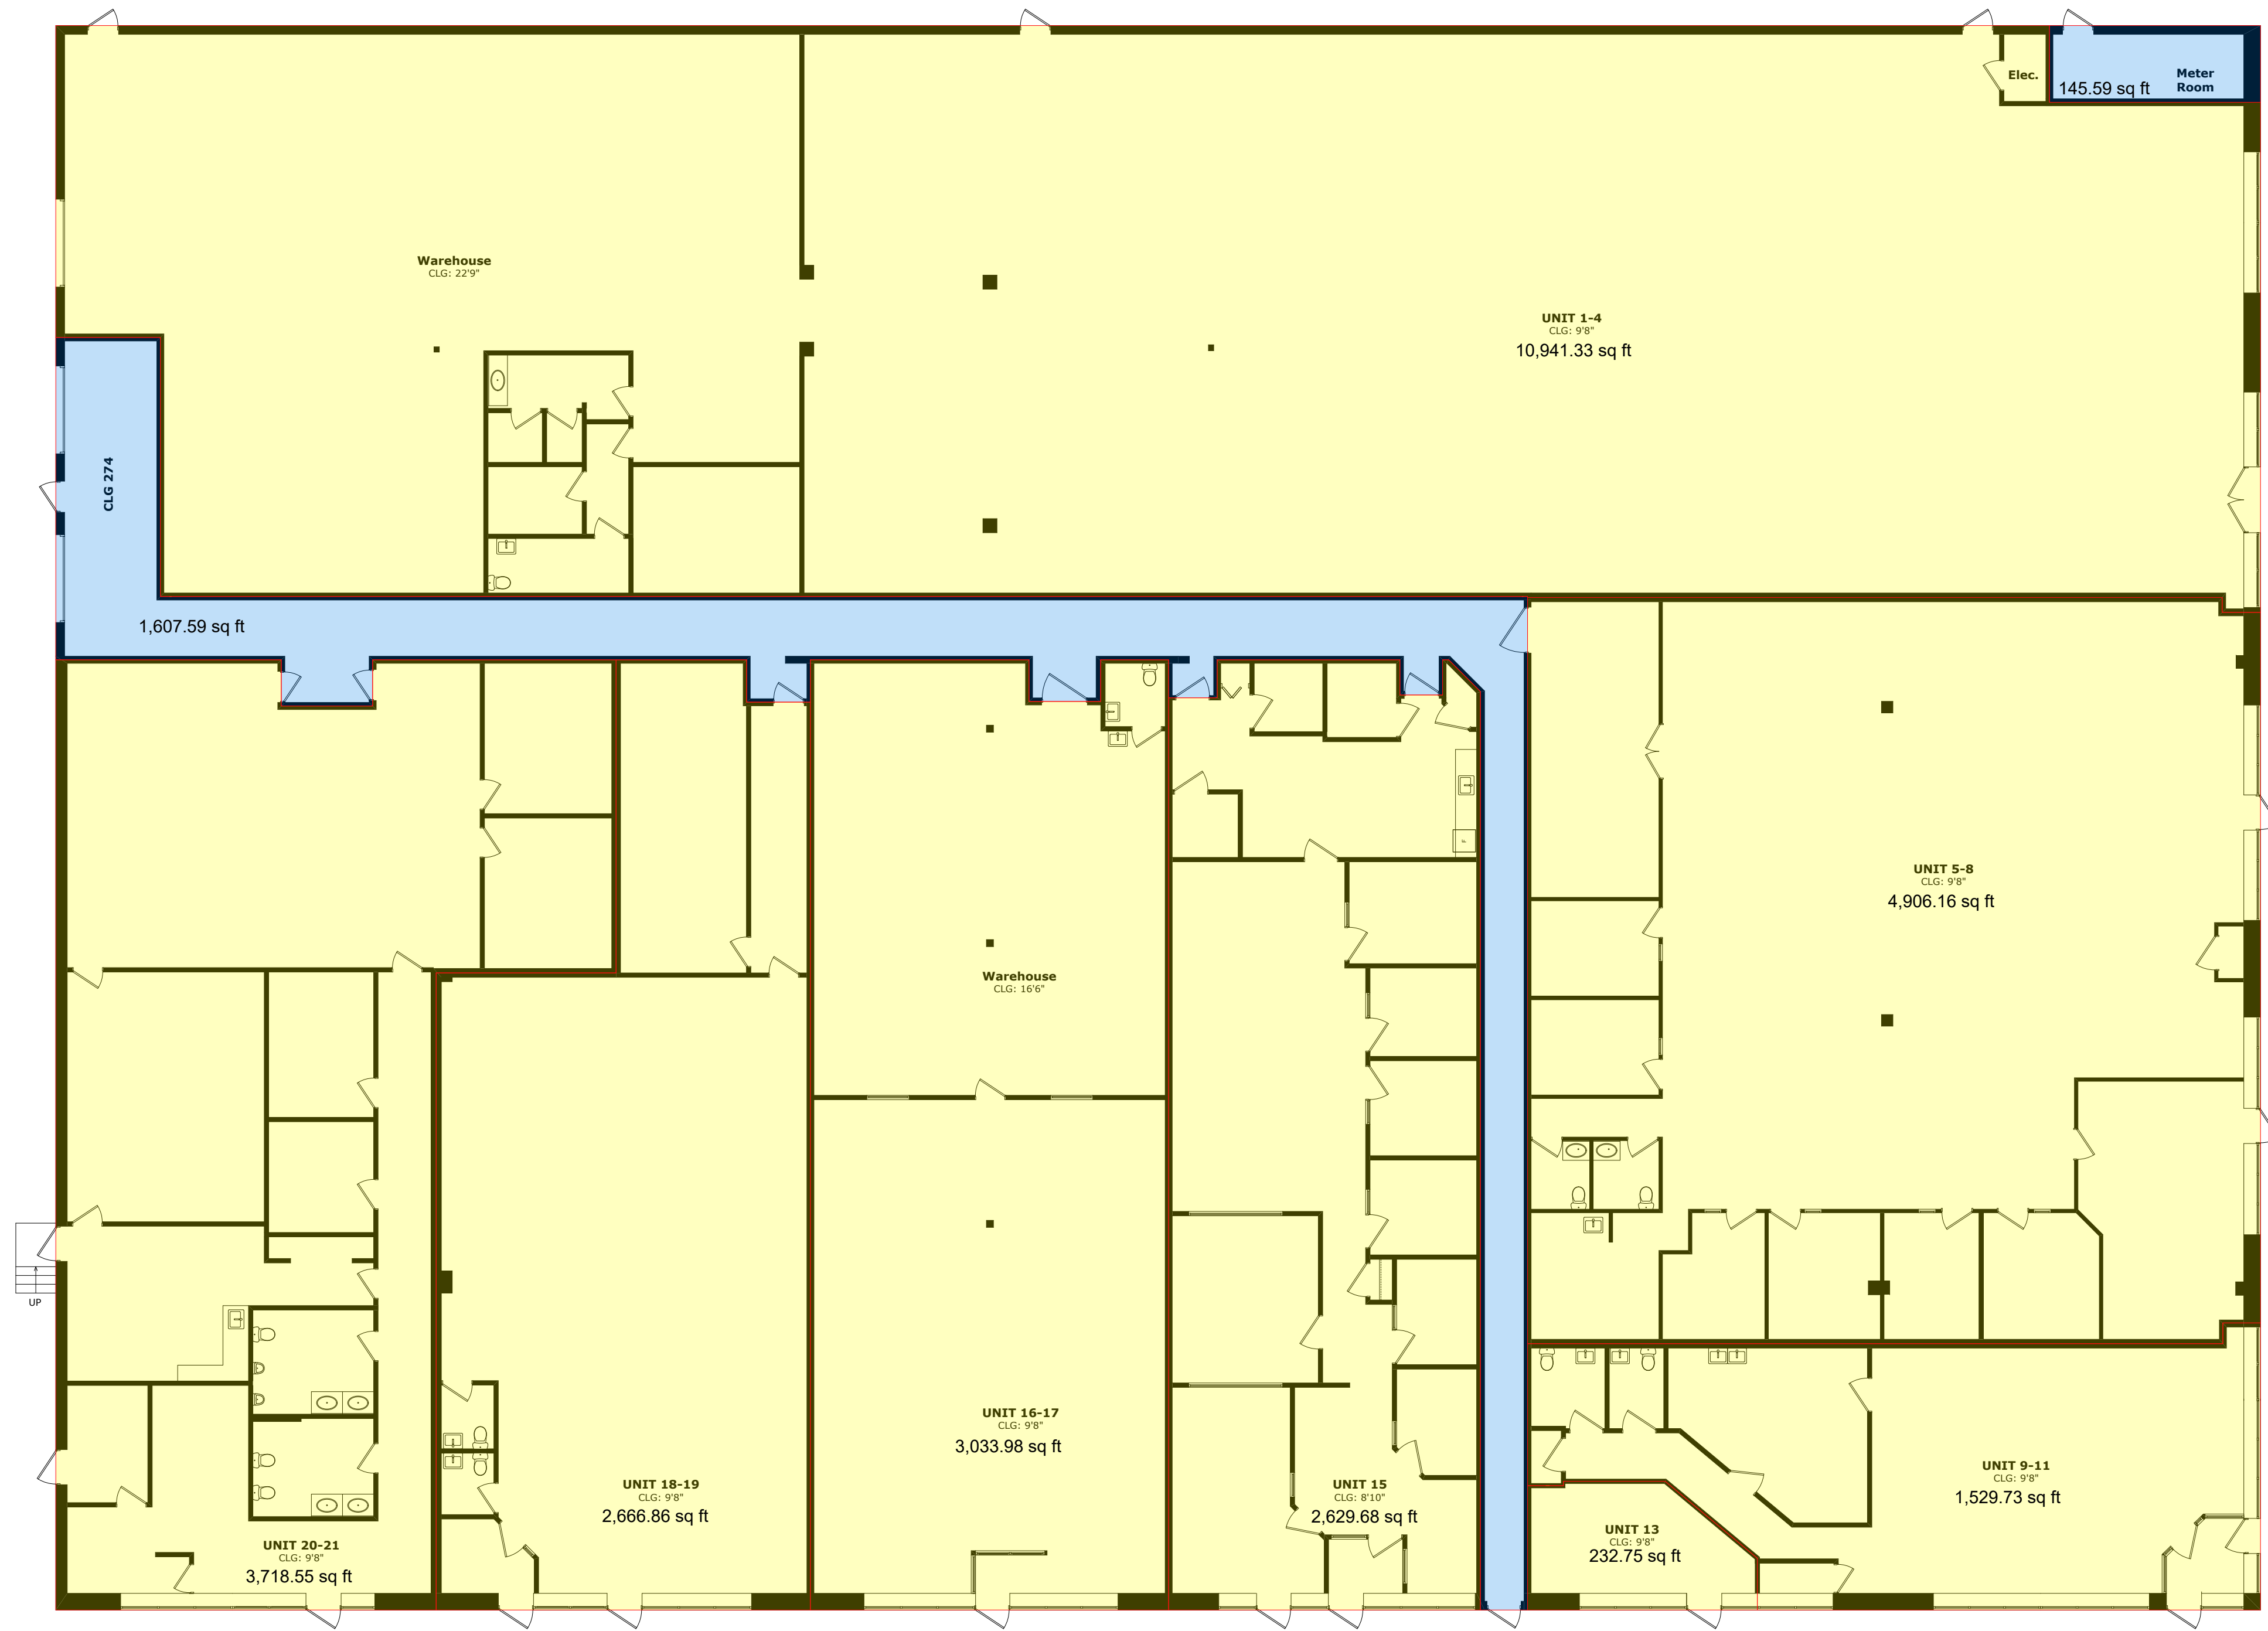

- BASIC LEASABLE AREA
- GROSS LEASABLE AREA
- BUILDING COMMON AREA

ADDRESS: 1790 DUNDAS STREET LEASABLE/Common AREA	SCALE 3/32" = 1'-0"	
This Product is Prepared by Houssmax.ca Using Laser Technology @2013 T: 647-309-6288 info@houssmax.ca Area computed in accordance with BOMA Standards		

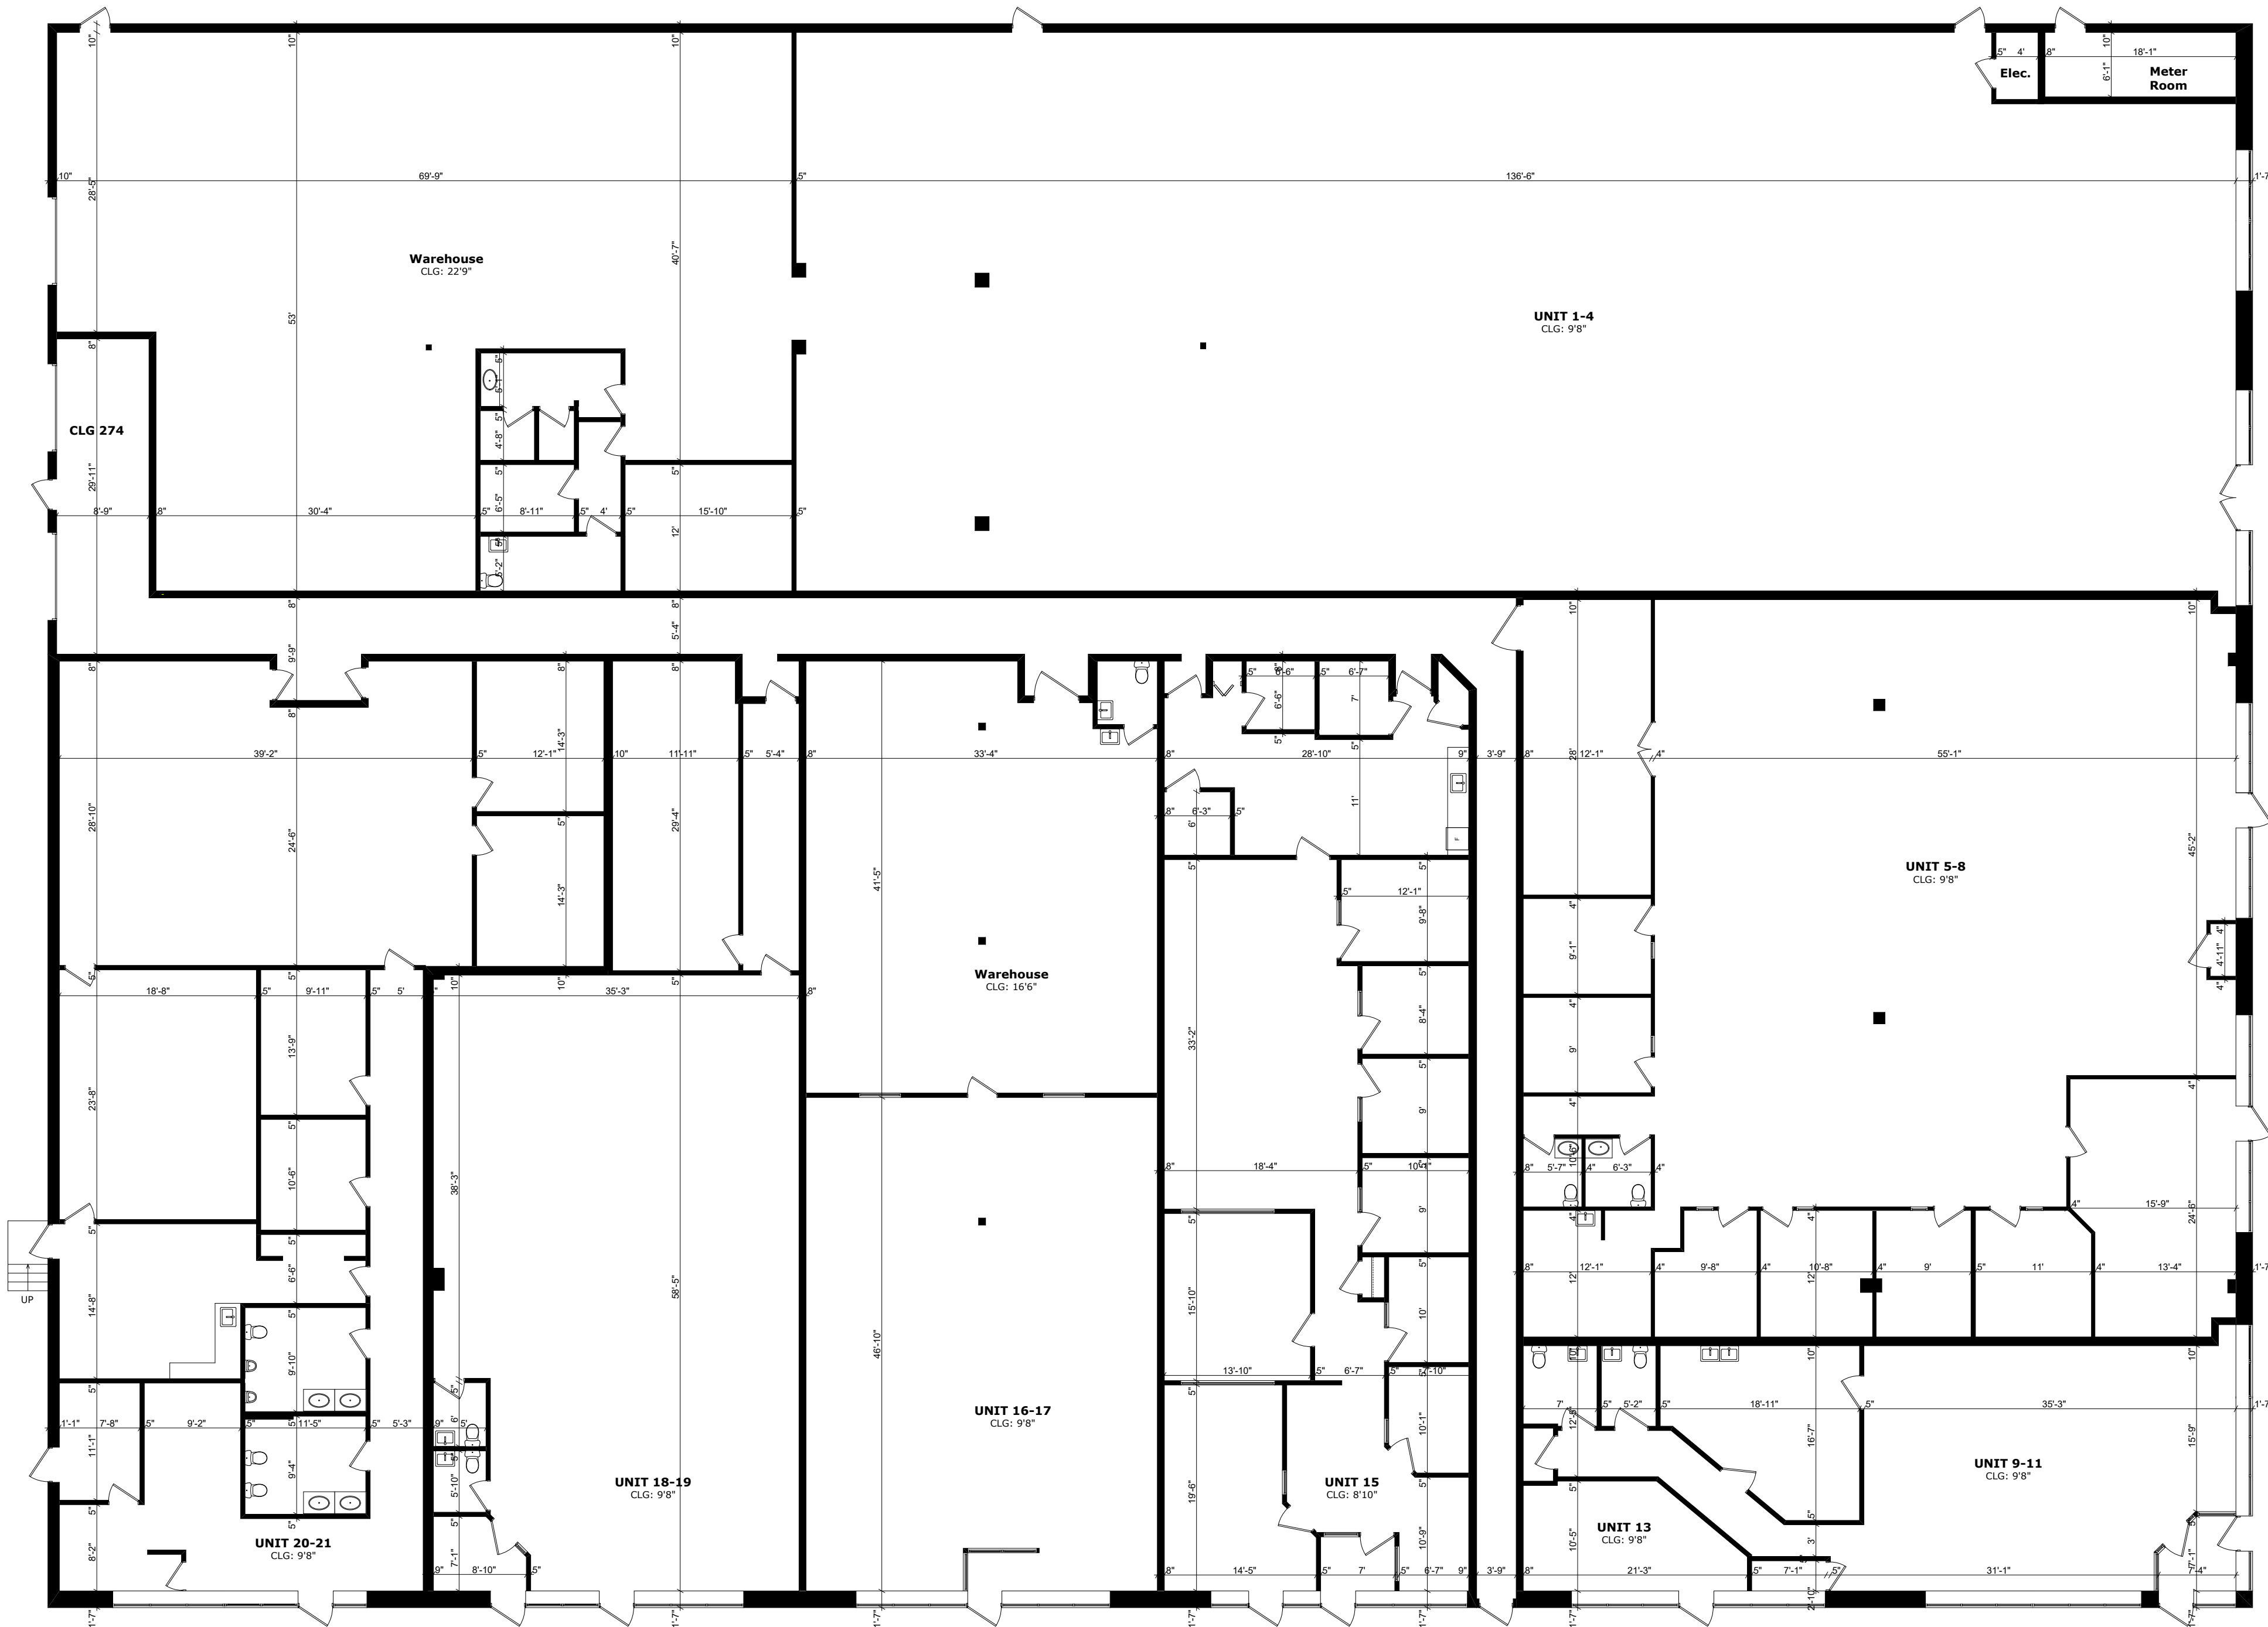

ADDRESS: 1790 DUNDAS STREET FLOOR PLAN	SCALE $3/32" = 1'-0"$		
	This Product is Prepared by Houssmax.ca Using Laser Technology @2013 T: 647-309-6288 info@houssmax.ca Area computed in accordance with BOMA Standards		