


# 3468 DRUMMOND STREET

## GROUND LEVEL

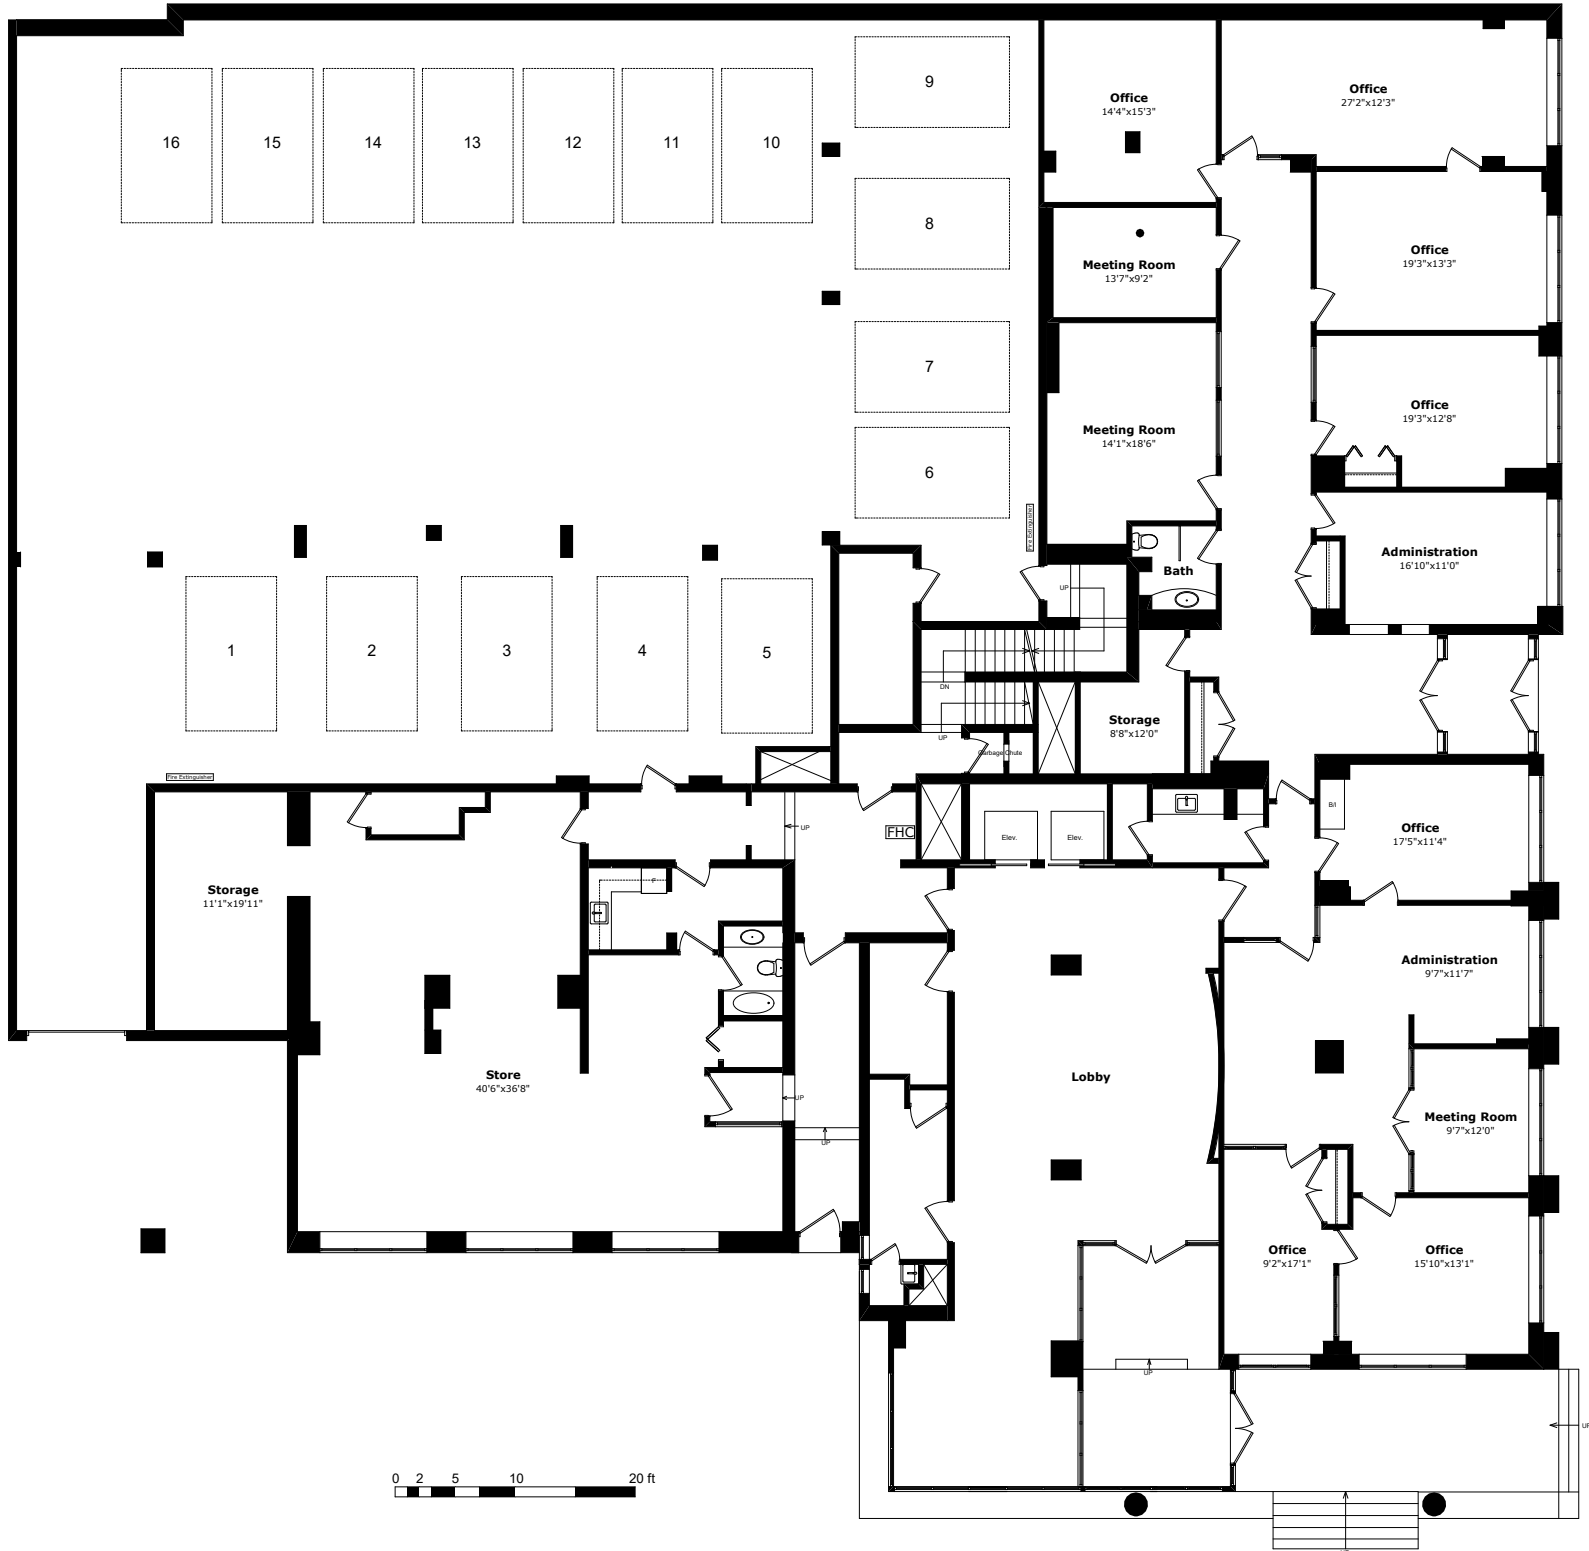


1/16" = 1'-0"

All plans and dimensions are an approximate and subject to change without notice. Note that plans and room dimensions may vary according to elevation. Suites are leased unfurnished. E.&O.E.

# 3468 DRUMMOND STREET

## 1ST-5TH LEVEL

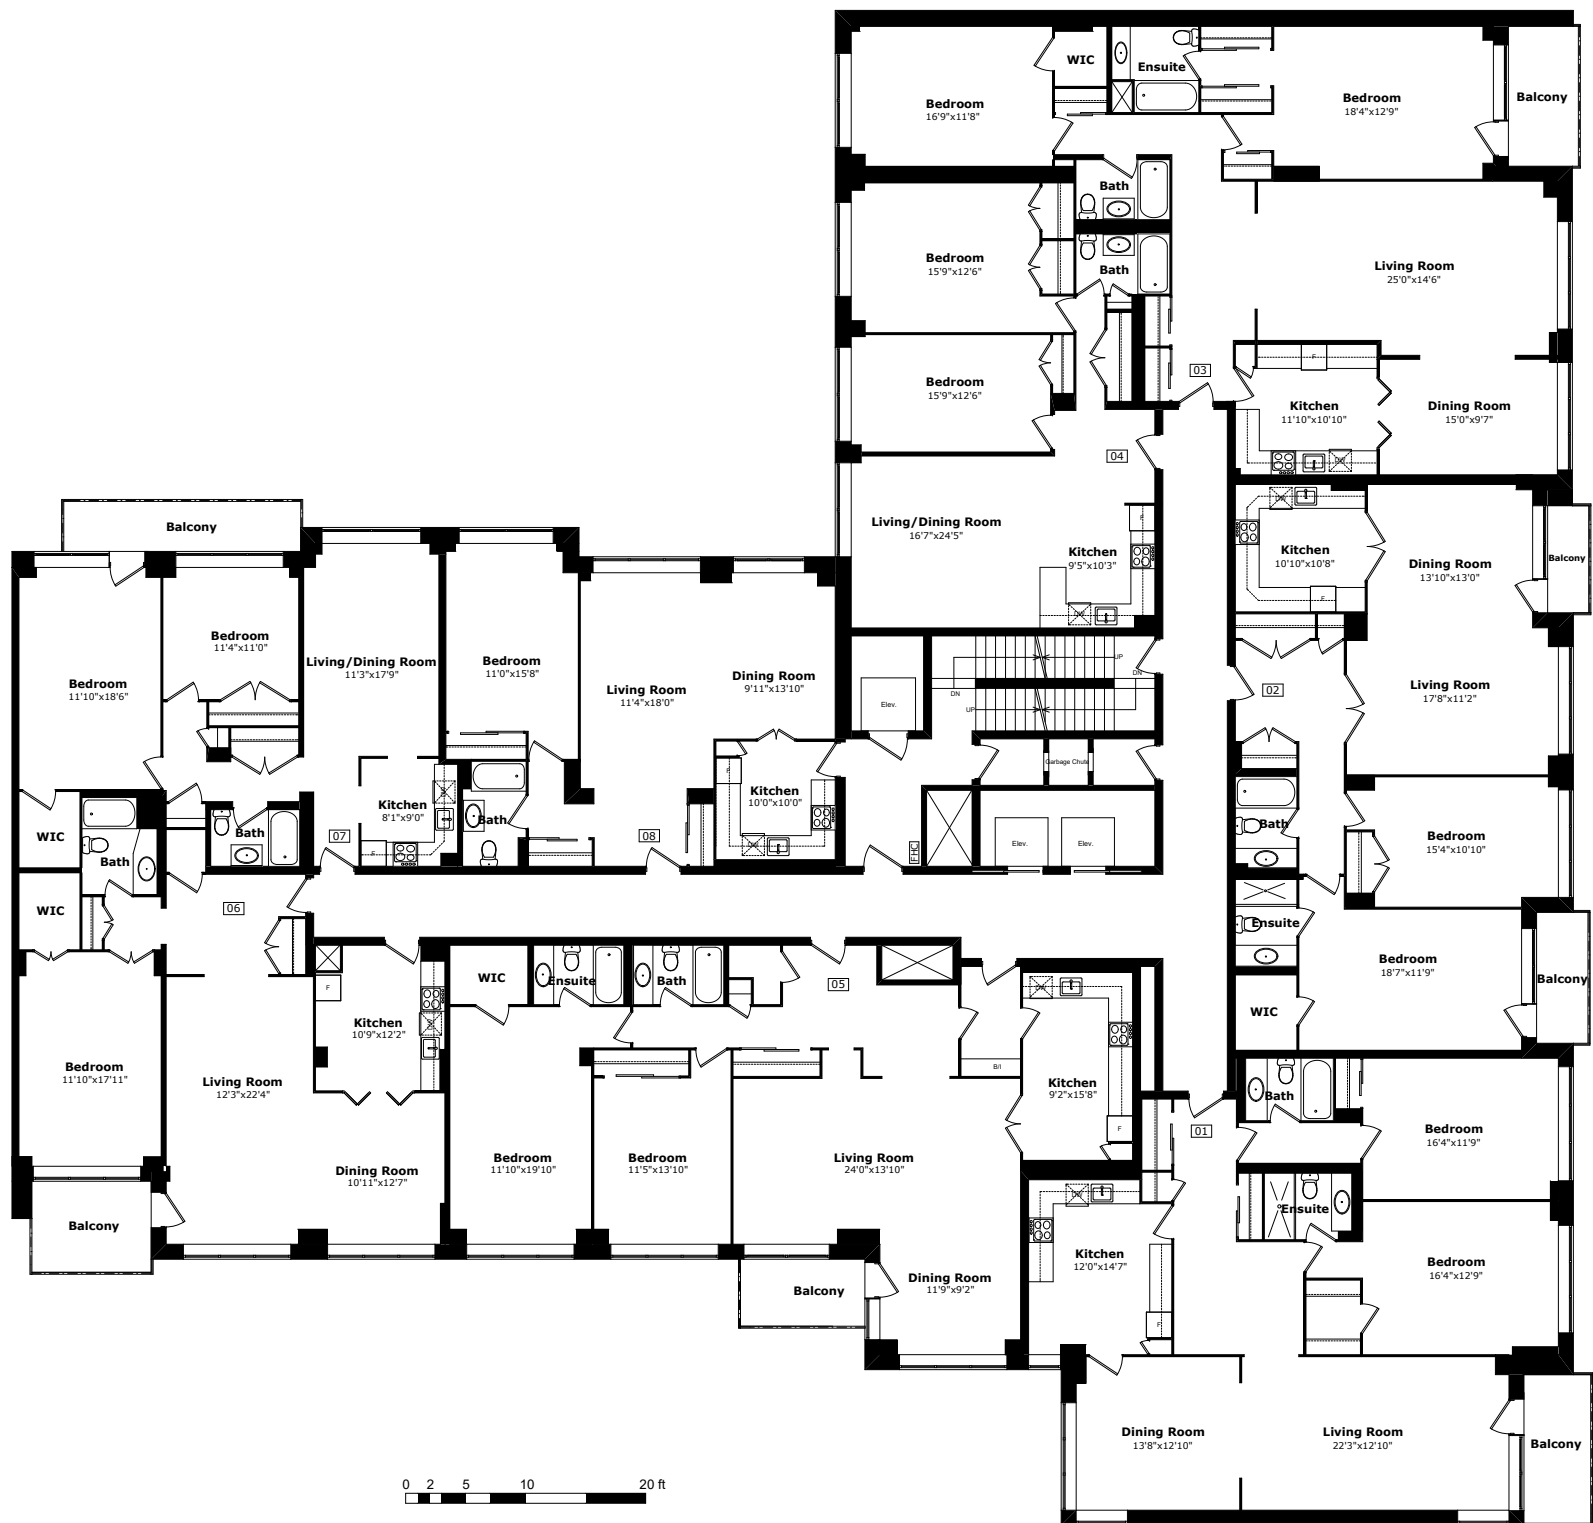


1/16" = 1'-0"

All plans and dimensions are an approximate and subject to change without notice. Note that plans and room dimensions may vary according to elevation. Suites are leased unfurnished. E.&O.E.

# 3468 DRUMMOND STREET

## 6TH-8TH LEVEL

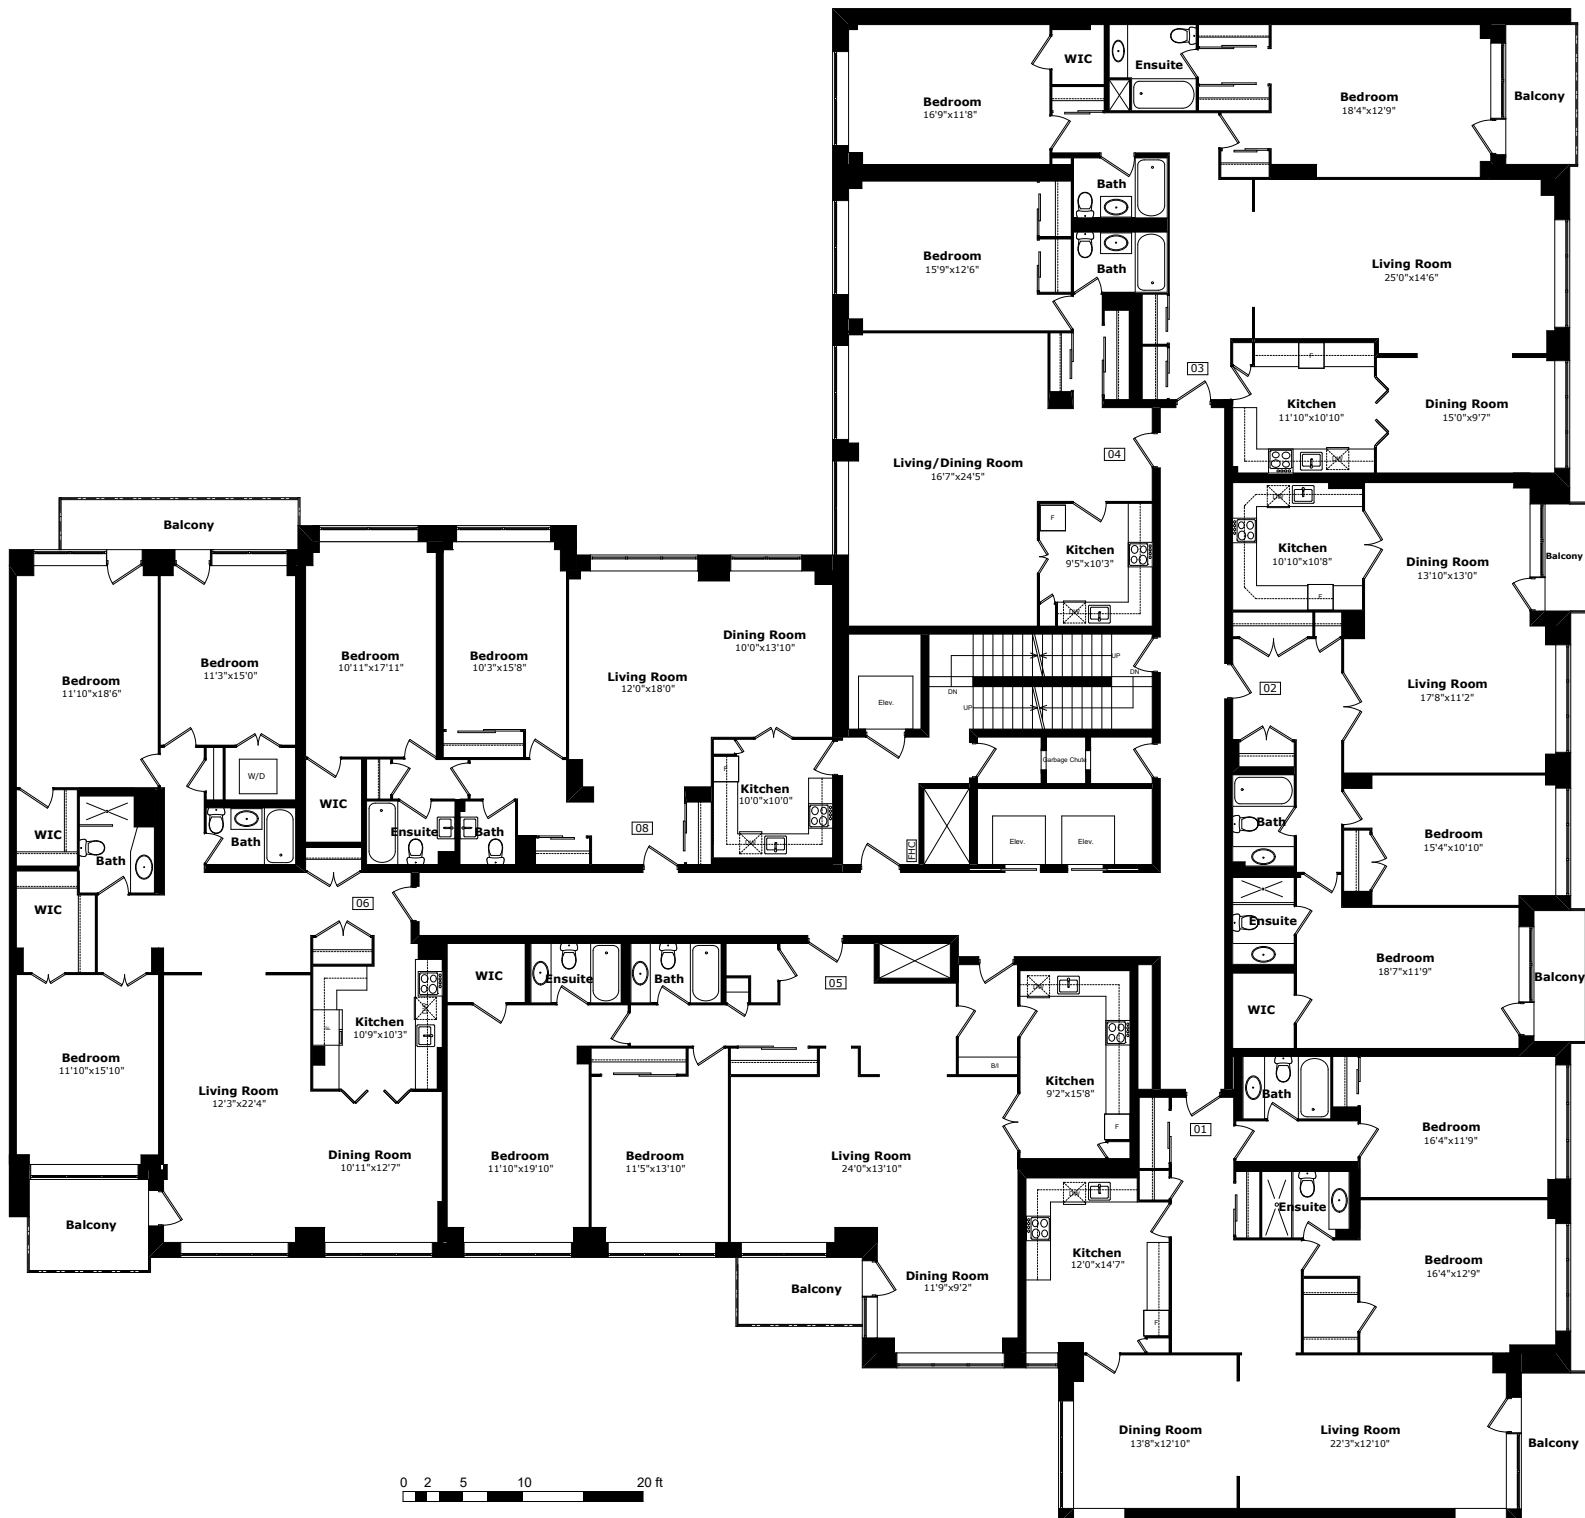


1/16" = 1'-0"

All plans and dimensions are an approximate and subject to change without notice. Note that plans and room dimensions may vary according to elevation. Suites are leased unfurnished. E.&O.E.

# 3468 DRUMMOND STREET

## 9TH-10TH LEVEL

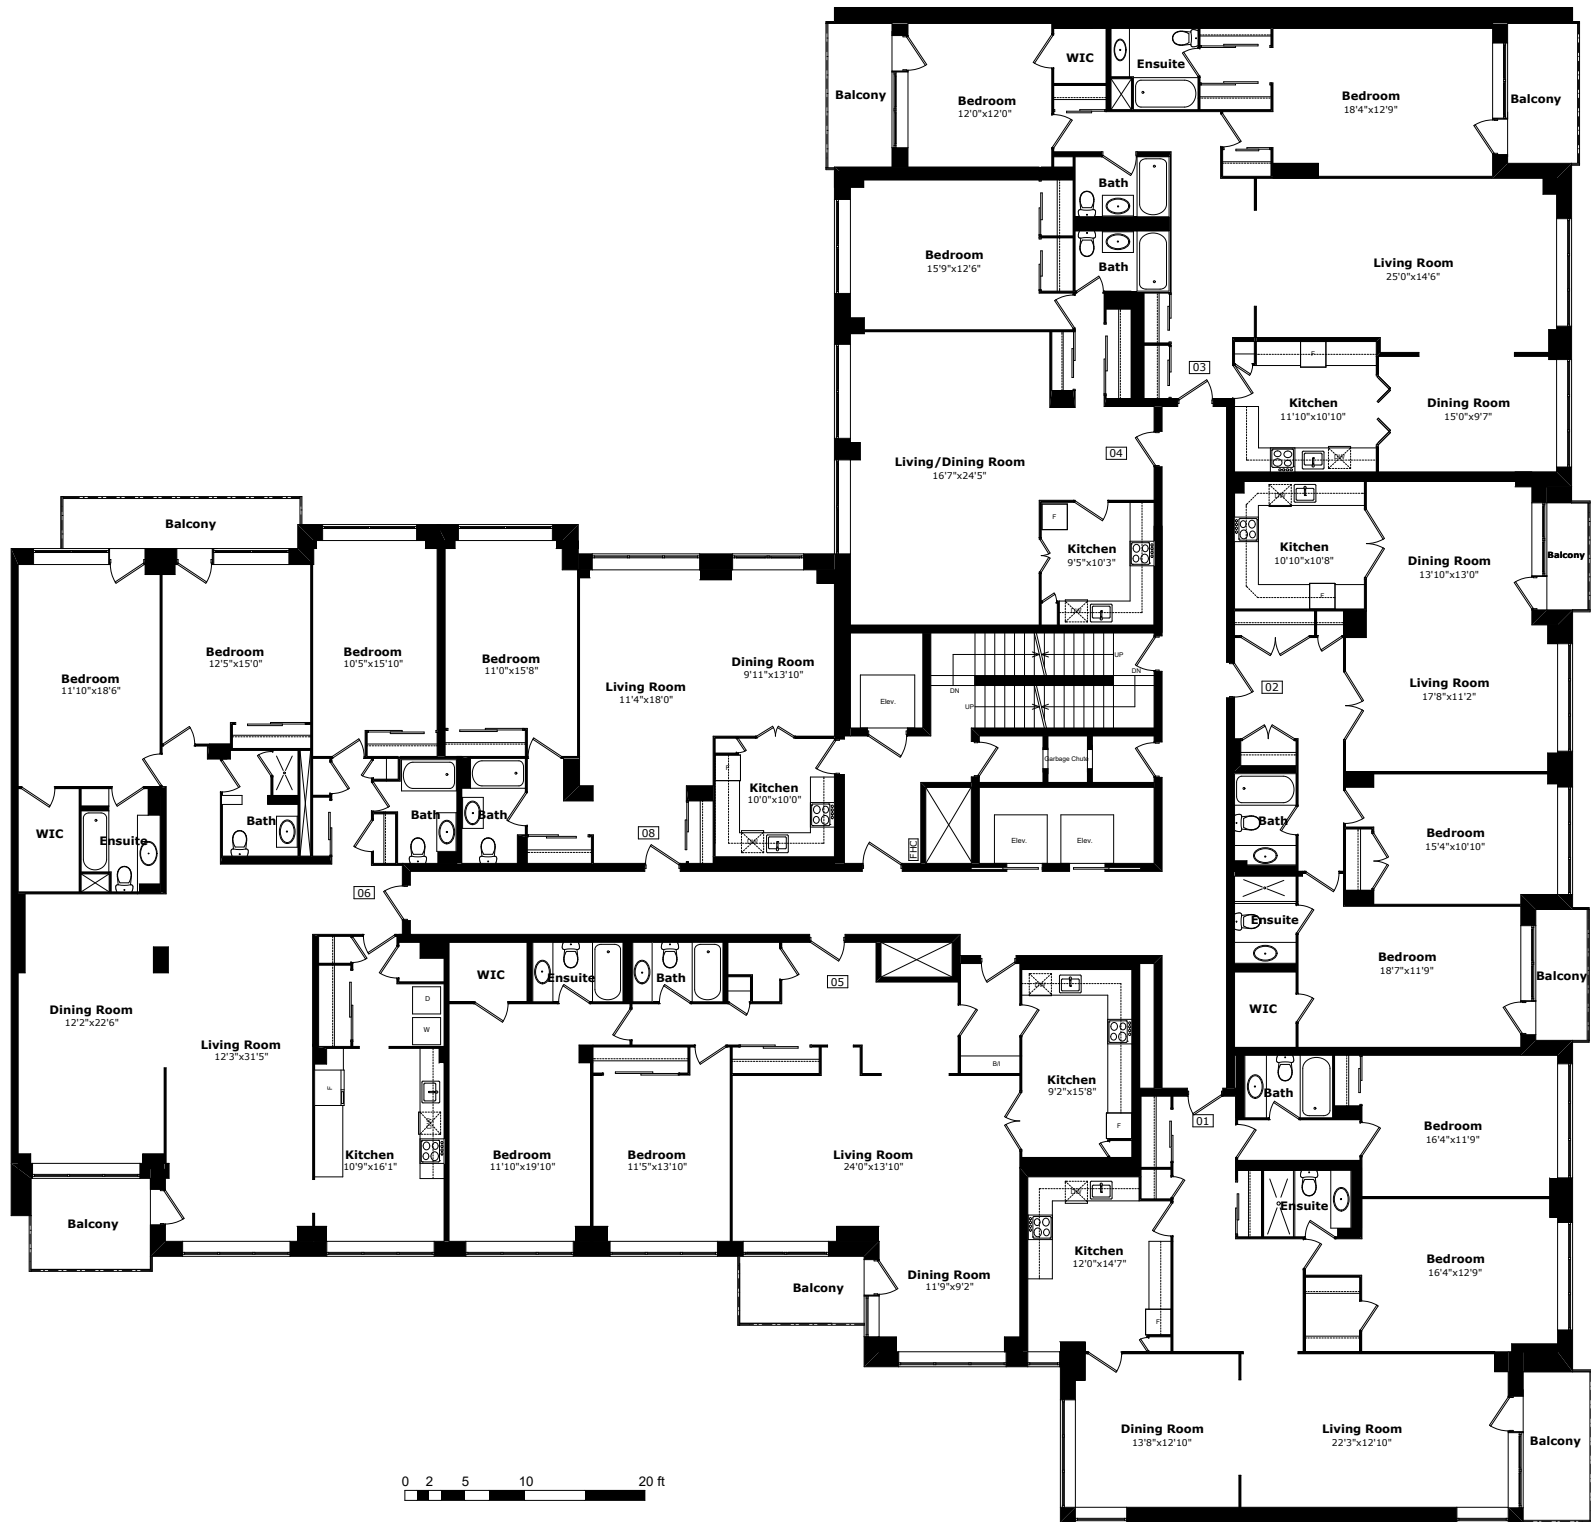


1/16" = 1'-0"

All plans and dimensions are an approximate and subject to change without notice. Note that plans and room dimensions may vary according to elevation. Suites are leased unfurnished. E.&O.E.

# 3468 DRUMMOND STREET

## 11TH LEVEL

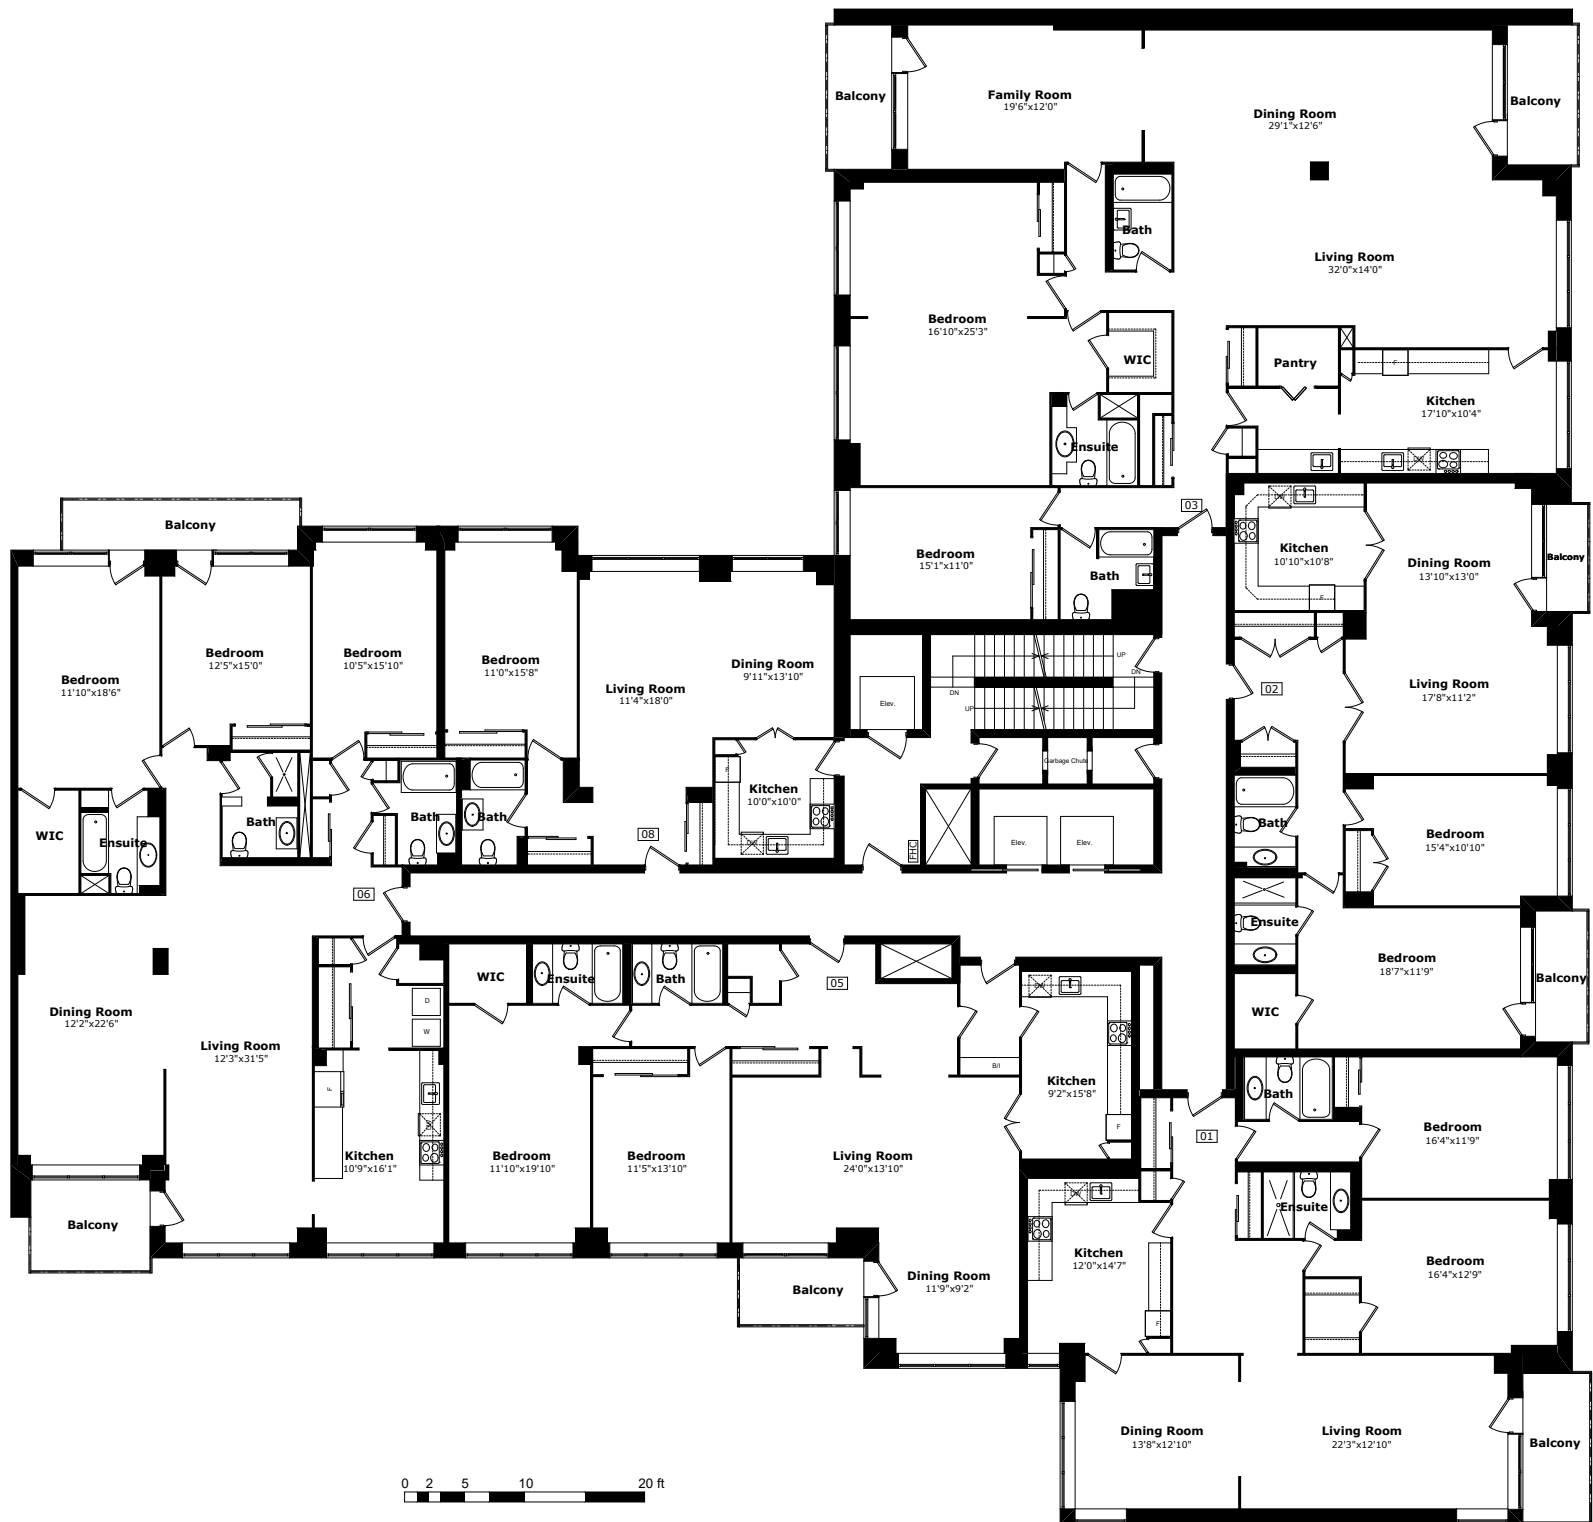


1/16" = 1'-0"

All plans and dimensions are an approximate and subject to change without notice. Note that plans and room dimensions may vary according to elevation. Suites are leased unfurnished. E.&O.E.

# 3468 DRUMMOND STREET

## 12TH LEVEL

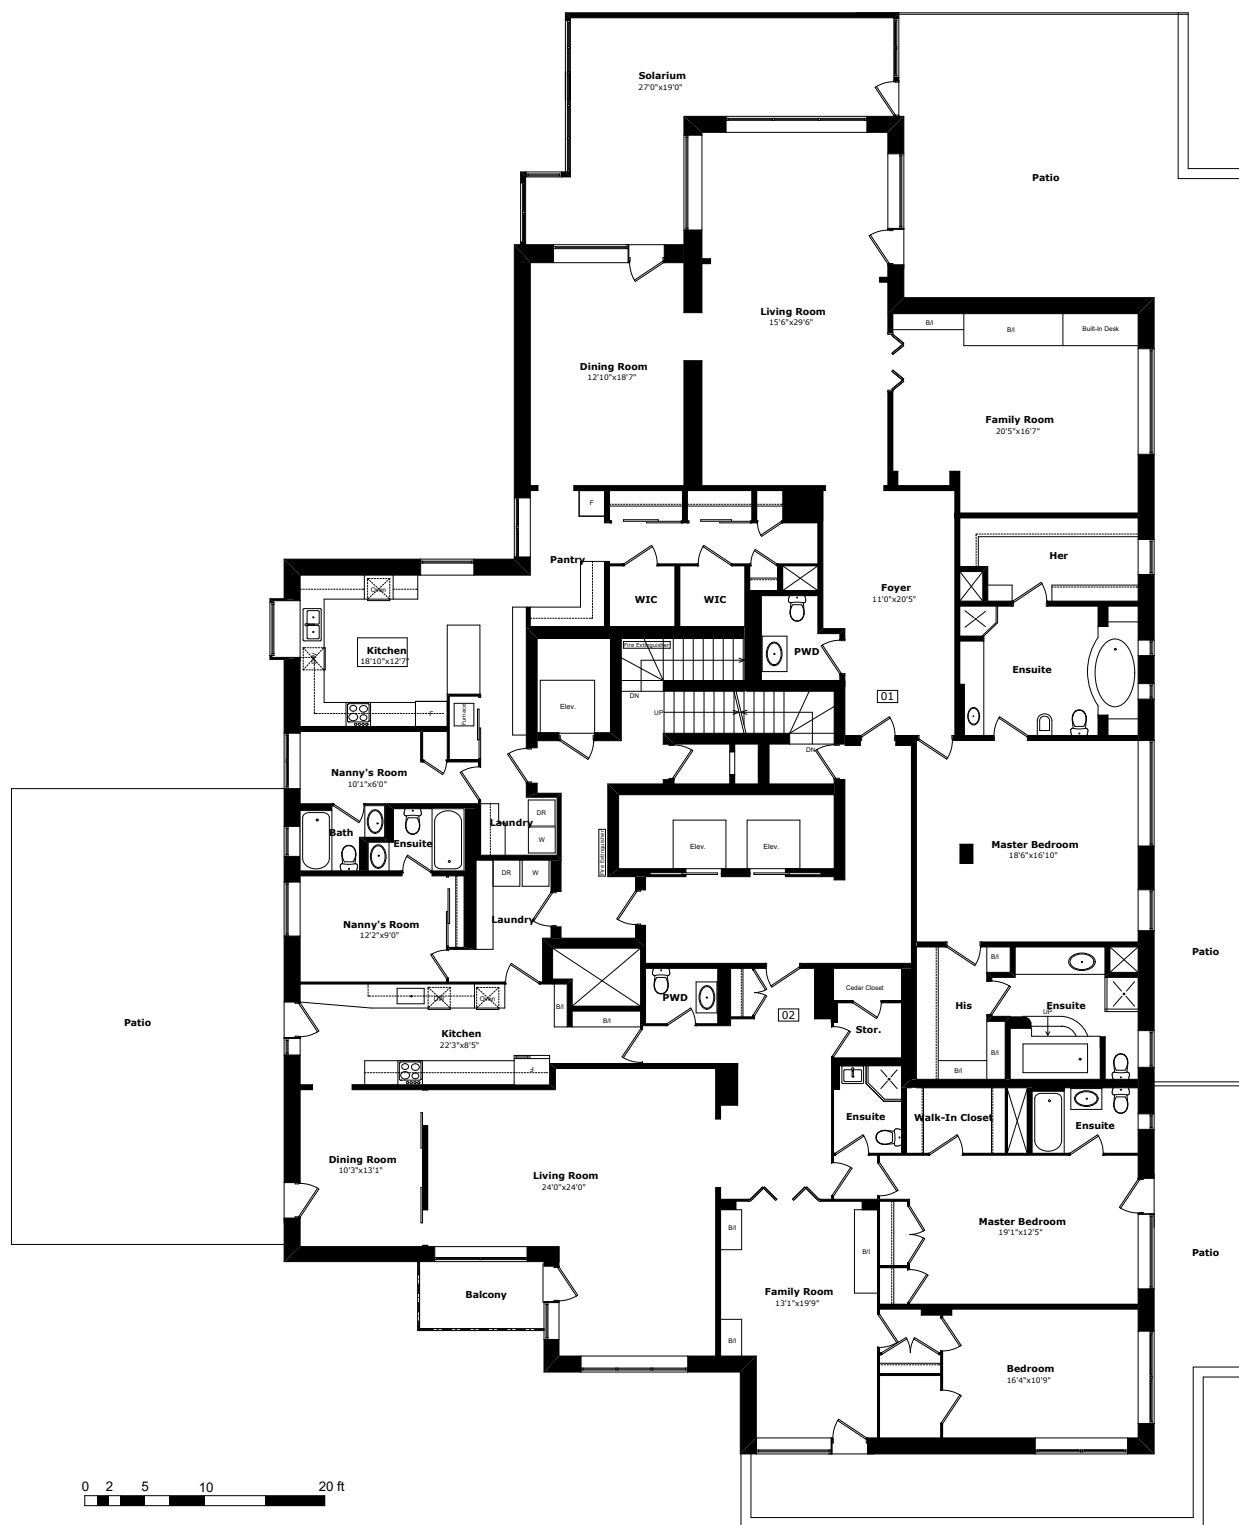


$$1/16" = 1'-0"$$

All plans and dimensions are an approximate and subject to change without notice. Note that plans and room dimensions may vary according to elevation. Suites are leased unfurnished. E.&O.E.

# 3468 DRUMMOND STREET

## BASEMENT LEVEL

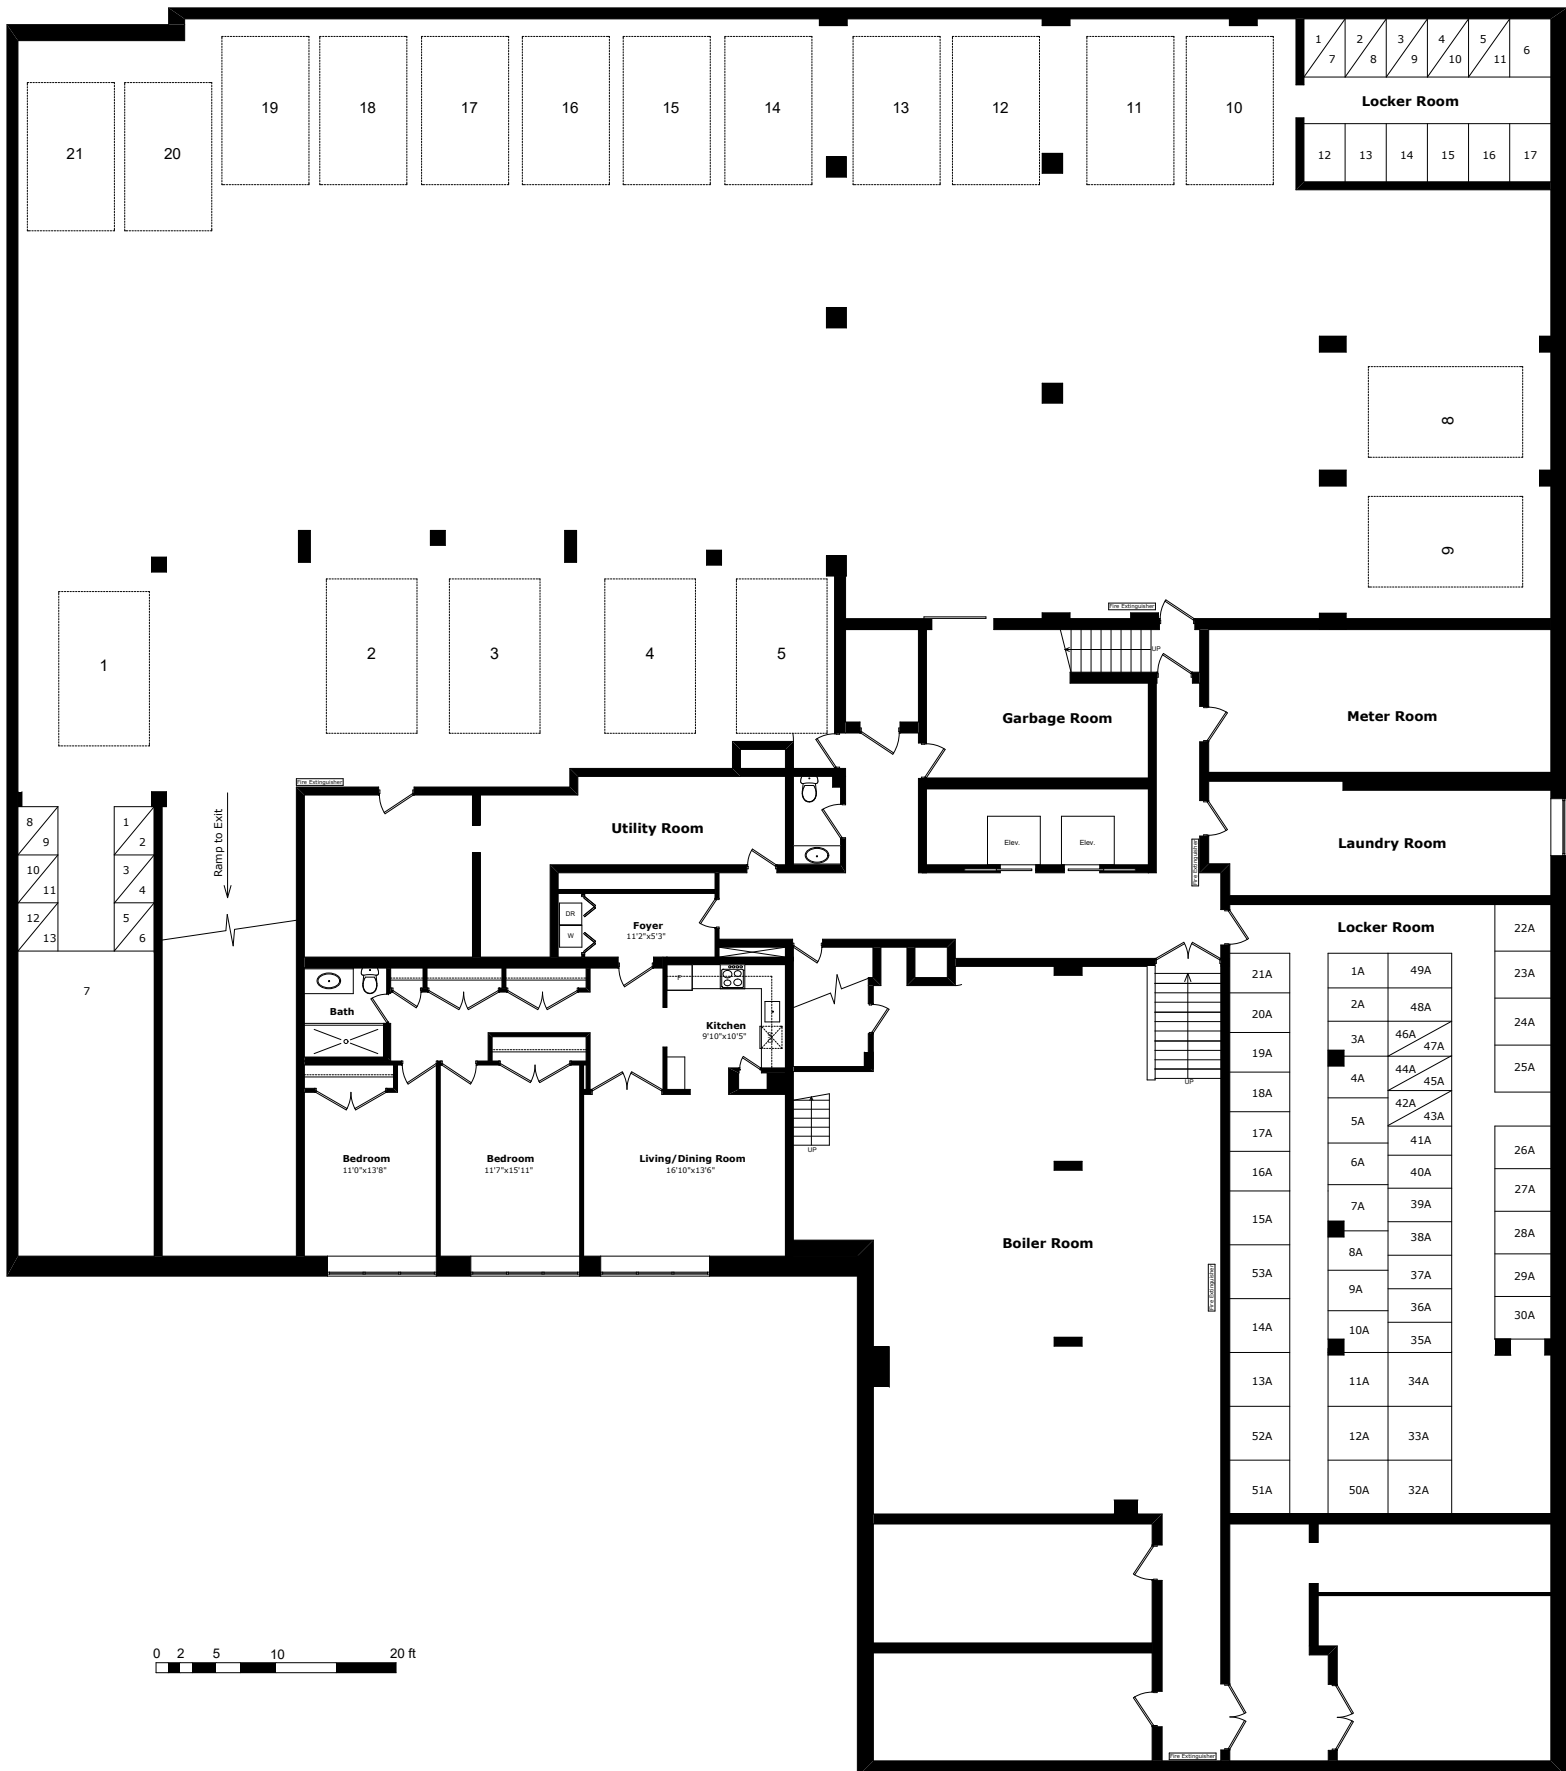

1/16" = 1'-0"

All plans and dimensions are an approximate and subject to change without notice. Note that plans and room dimensions may vary according to elevation. Suites are leased unfurnished. E.&O.E.