

**UNIT 113-115**  
CLG: 9'3"

**UNIT 101**  
CLG: 9'0"

**UNIT 103**  
CLG: 9'0"


**UNIT 111**  
CLG: 9'3"


**UNIT 107**  
CLG: 9'0"


**UNIT 121**  
CLG: 9'0"

**Elev.**

ADDRESS: <b>1135 ADELAIDE STREET N</b> <b>MAIN FLOOR PLAN</b>	SCALE <b>1/8" = 1'-0"</b>		
	<small>This Product is Prepared by Home Max Tour Inc.          Using Laser Technology (04.2013)          T: 647-960-4688   contact@homemaxtour.ca          Area computed in accordance          with BCMA (1996) Standards</small>		

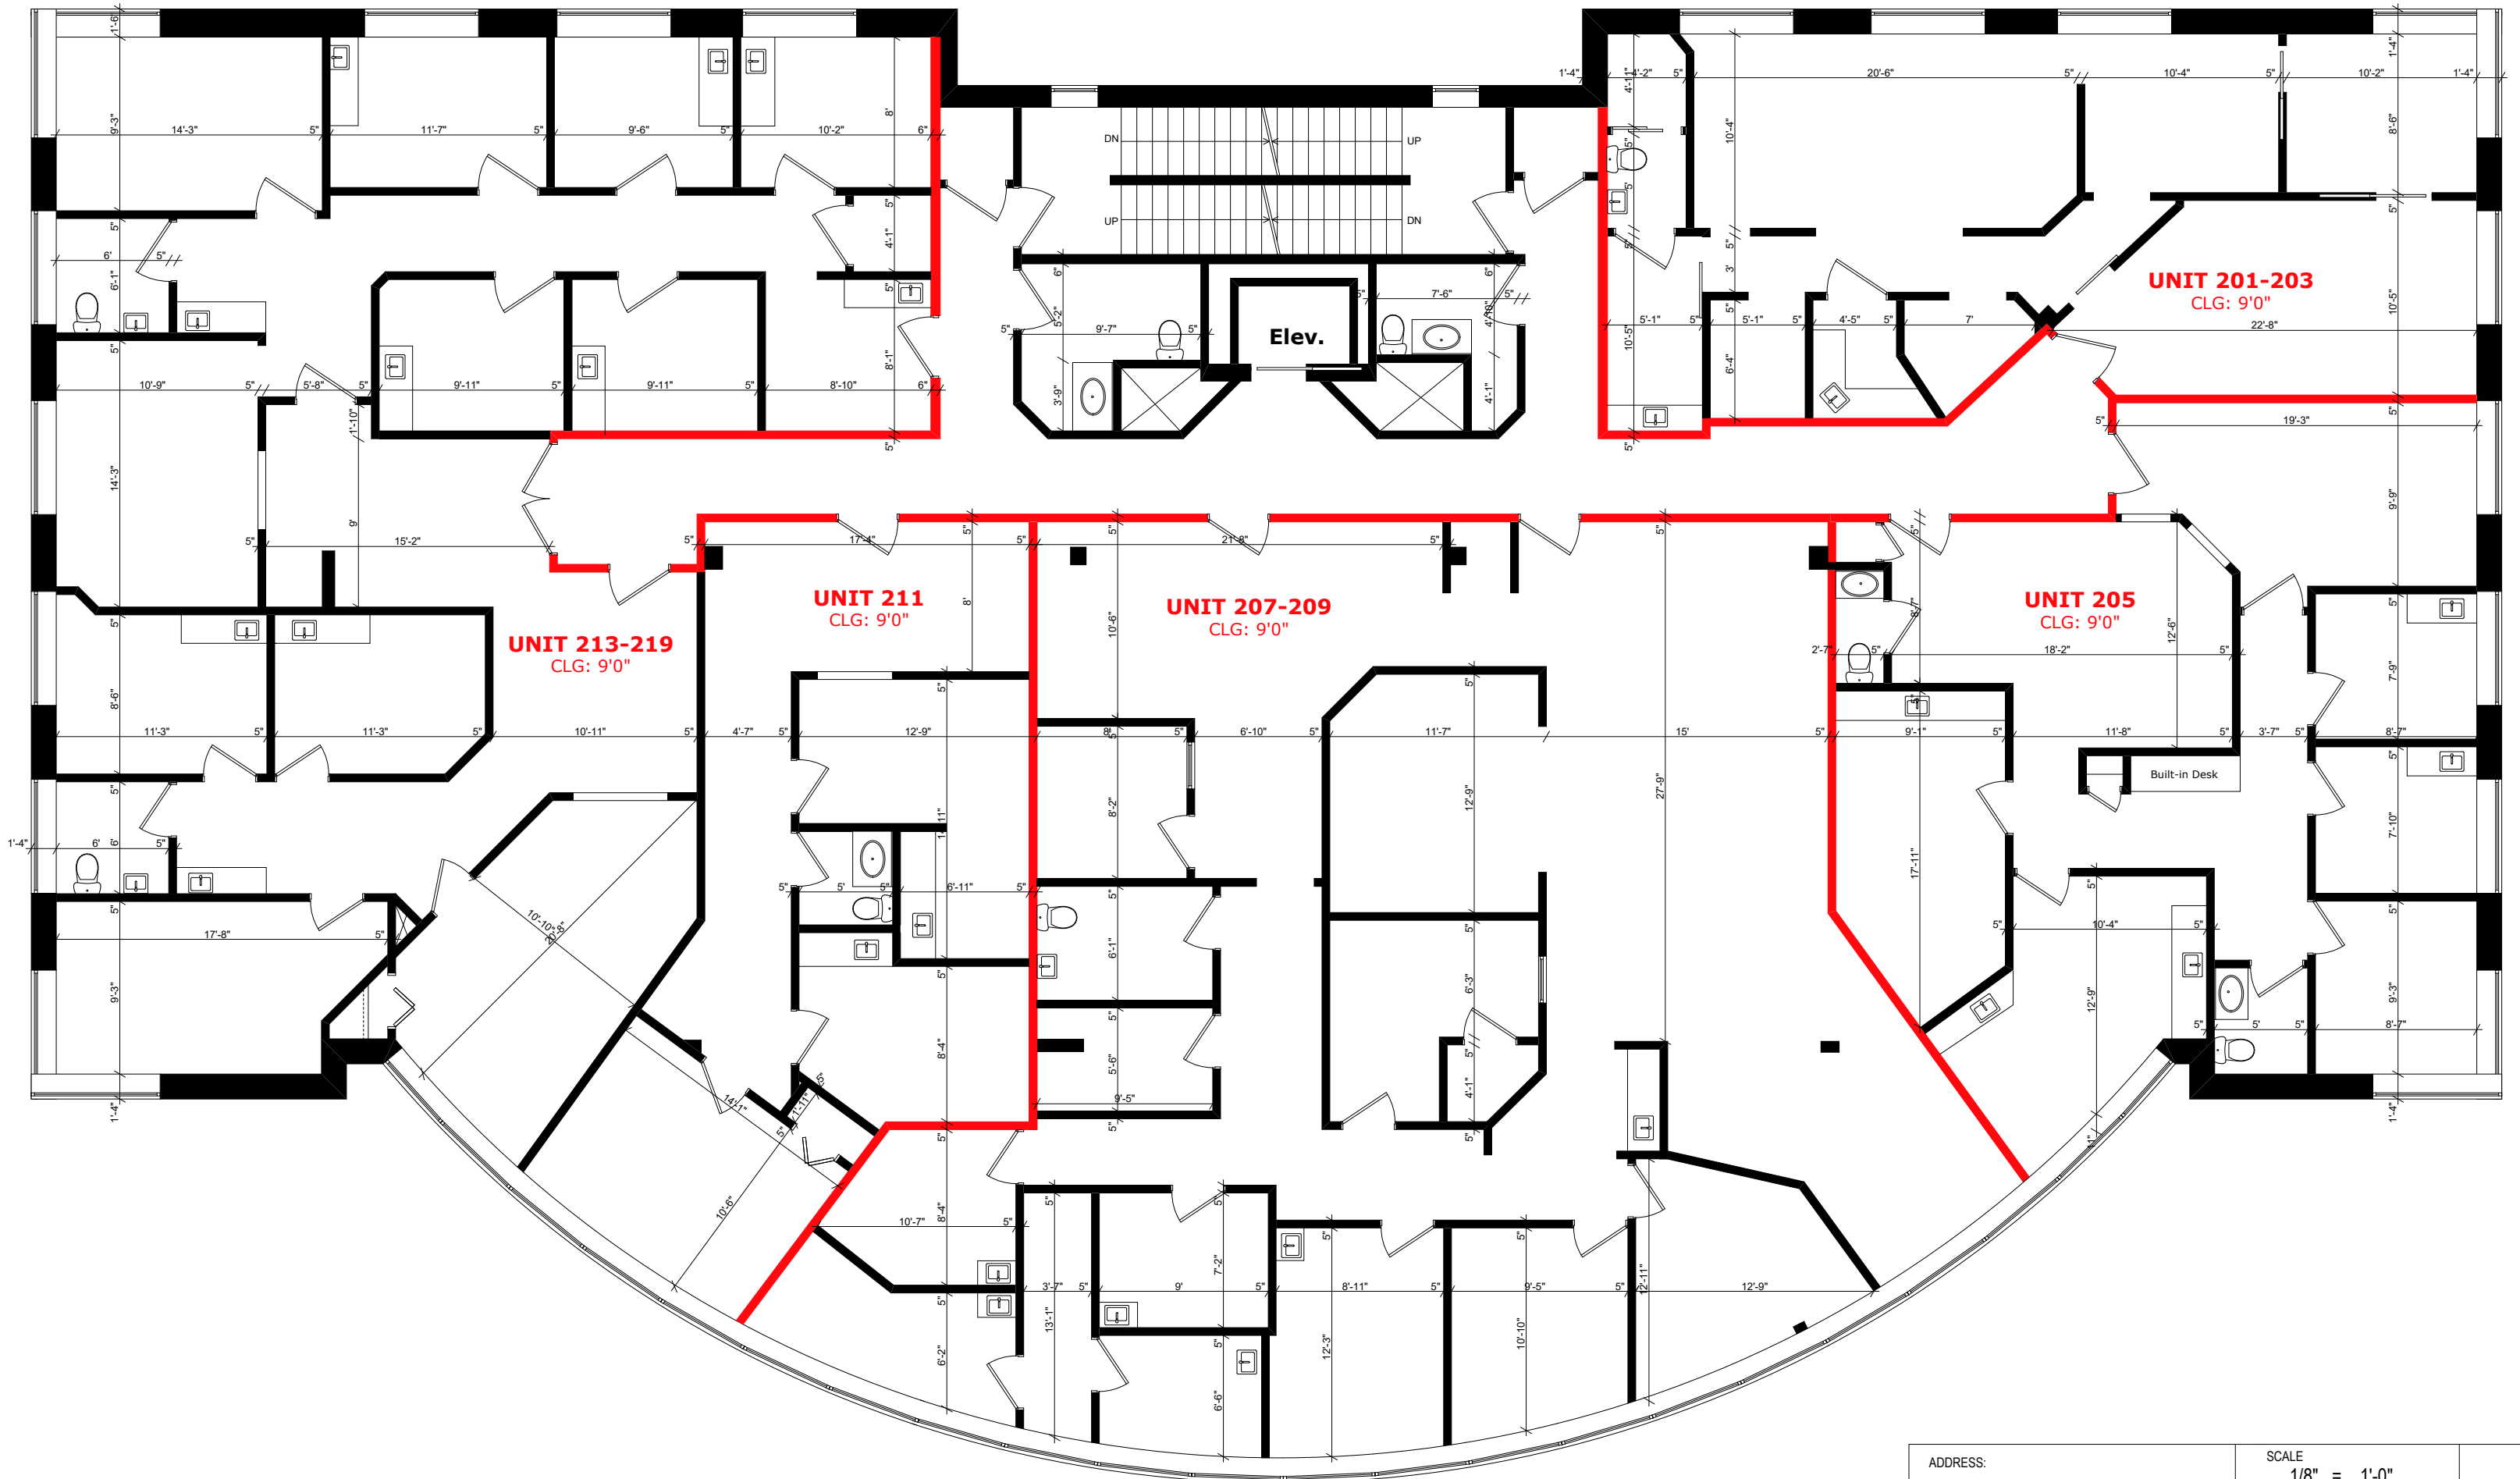

<p>ADDRESS:  <b>1135 ADELAIDE STREET N</b>  <b>SECOND FLOOR PLAN</b></p>	<p>SCALE  <b>1/8" = 1'-0"</b></p> <p><small>This Product is Prepared by Home Max Tour Inc.          Using Laser Technology (04.2013)          T: 647-960-4688   contact@homemaxtour.ca          Area computed in accordance          with BCMA (1996) Standards</small></p>	
--	---	---

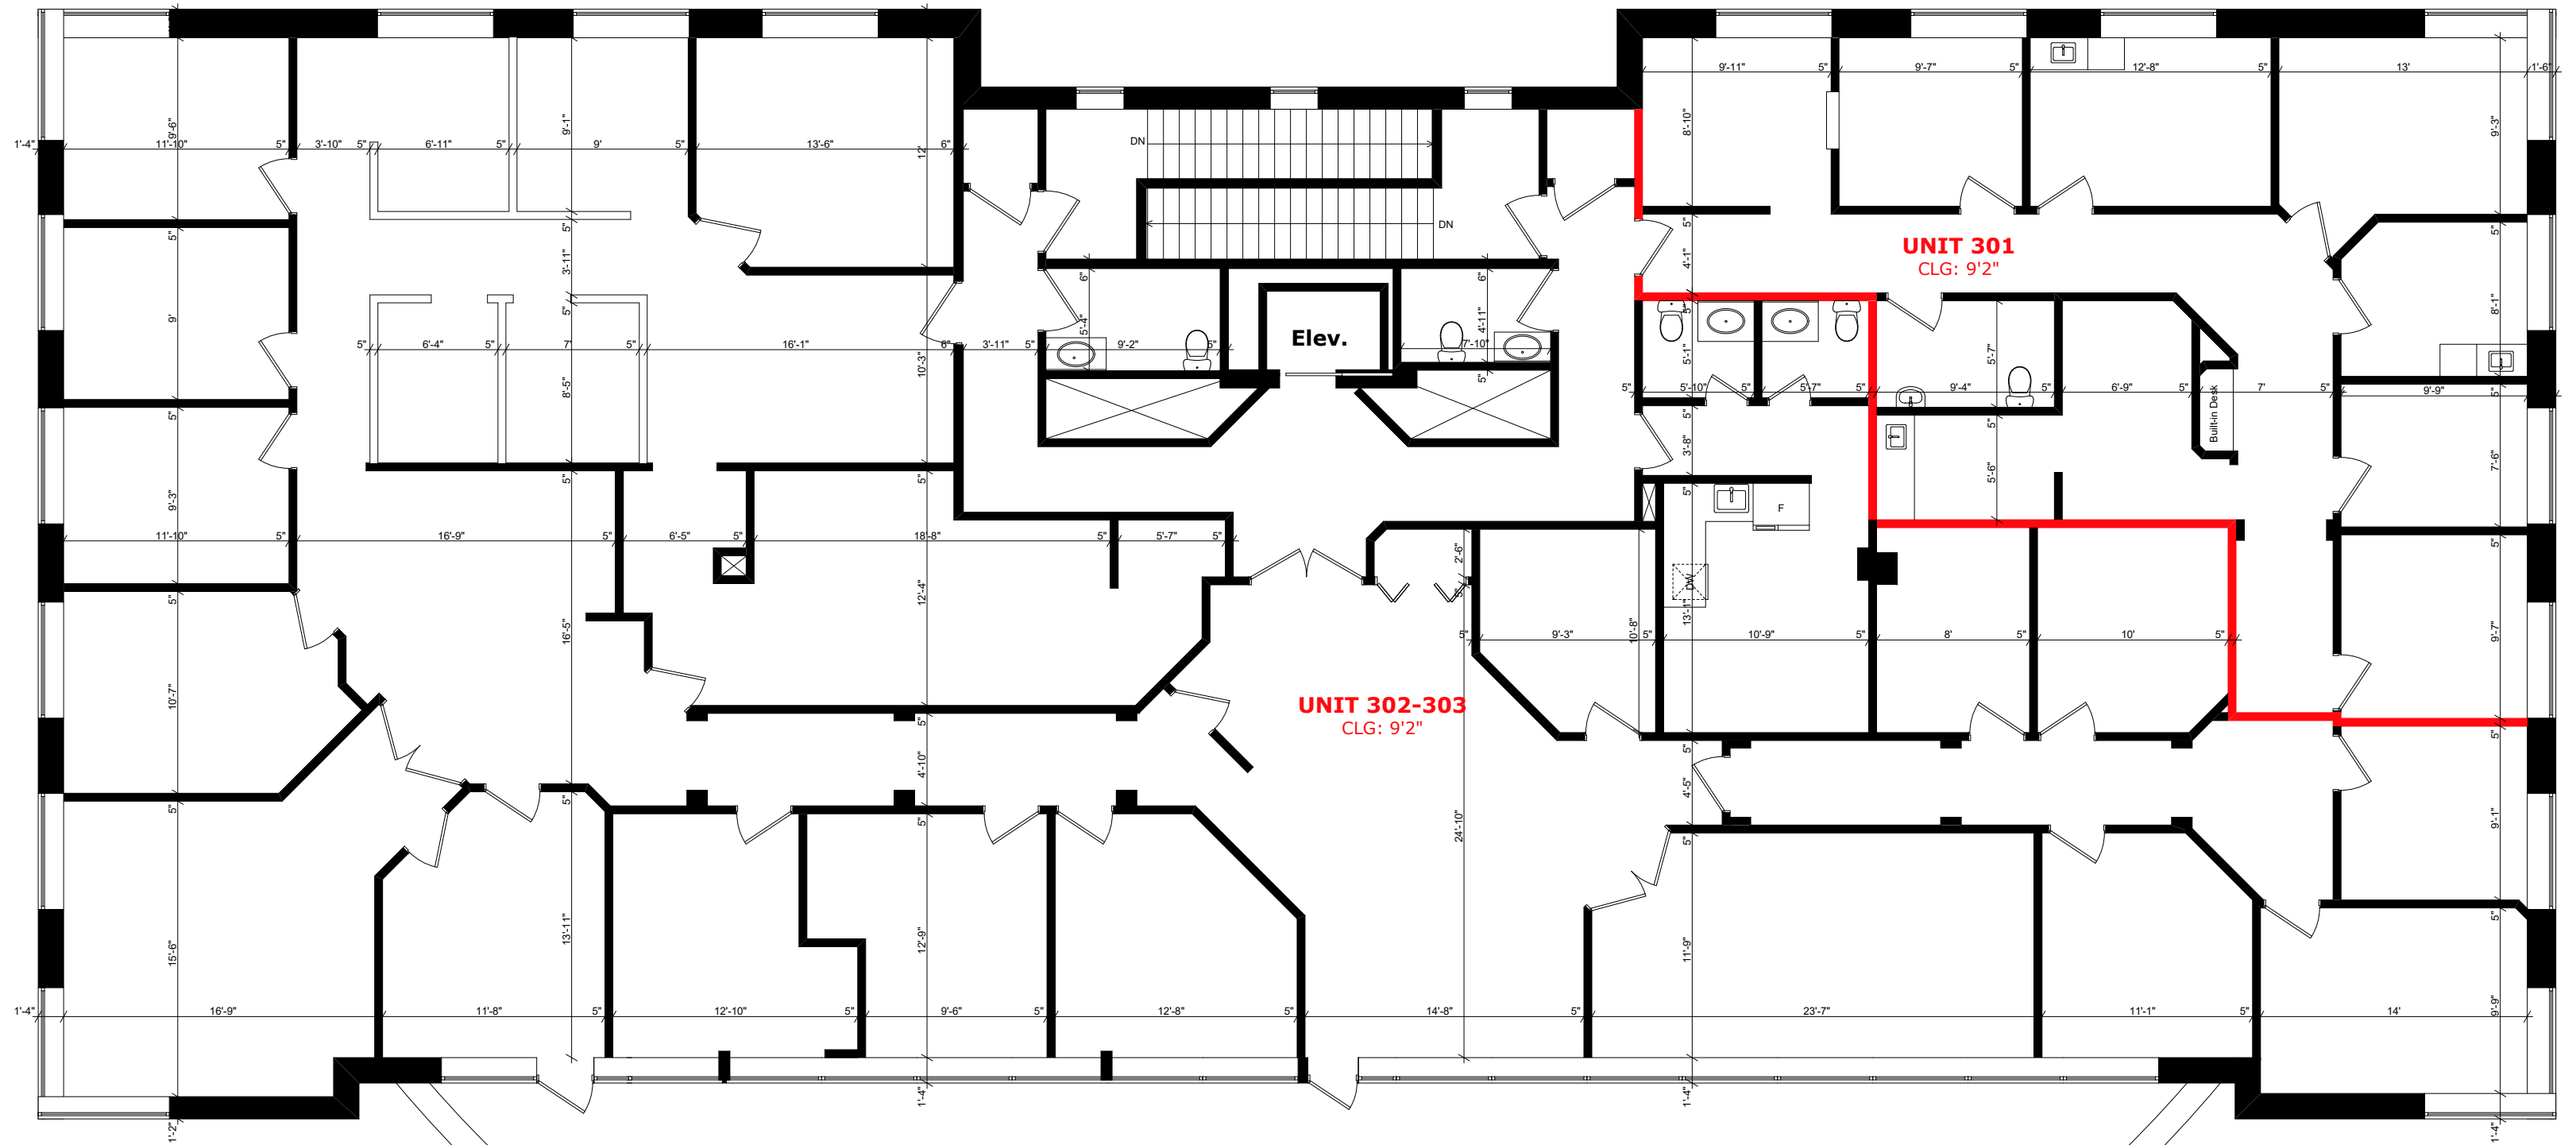

**UNIT 301**  
CLG: 9'2"

**UNIT 302-303**  
CLG: 9'2"

**Elev.**

**Roof Patio**

<p>ADDRESS: <b>1135 ADELAIDE STREET N</b> <b>THIRD FLOOR PLAN</b></p>	<p>SCALE <b>1/8" = 1'-0"</b></p> <p><small>This Product is Prepared by Home Max Tour Inc. Using Laser Technology (04.2013) T: 647-960-4688   contact@homemaxtour.ca Area computed in accordance with BCMA (1996) Standards</small></p>	
---	--	--